


1	LOCATION OF WATER WELL: County: Kingman	Fraction C N$\frac{1}{2}$ $\frac{1}{4}$ N$\frac{1}{2}$ $\frac{1}{4}$ SW $\frac{1}{4}$	Section Number 12	Township Number T 29 S	Range Number R 9W E/W
---	---	--	-----------------------------	----------------------------------	---------------------------------

Distance and direction from nearest town or city street address of well if located within city?

2 E. 2 N of Willowdale, Kansas

2	WATER WELL OWNER:	Ramco Drilling Company	
	RR#, St. Address, Box # :	Box 367	Board of Agriculture, Division of Water Resources
	City, State, ZIP Code :	Andover, Kansas 67022	Application Number: Unknown

3	LOCATE WELL'S LOCATION WITH AN "X" IN SECTION BOX:	4	DEPTH OF COMPLETED WELL: 81 ft.	ELEVATION: Unknown
---	--	---	---------------------------------	--------------------

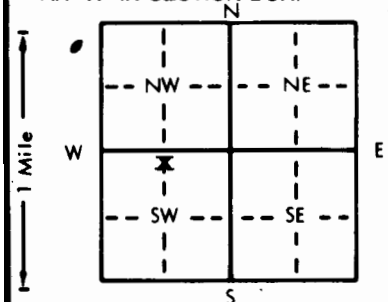

4. DEPTH OF COMPLETED WELL. 81 ft. ELEVATION: Unknown
Depth(s) Groundwater Encountered 1. 30 ft. 2. ft. 3. ft.

Depth(s) Groundwater Encountered 1. 30 ft. 2. ft. 3. ft.
WELL'S STATIC WATER LEVEL 30 ft. below land surface measured on mo/day/yr 7/14/81

Pump test data:	Well water was		ft. after		hours pumping		gpm		
Est. Yield	60	gpm:	Well water was		ft. after		hours pumping		gpm
Bore Hole Diameter	8	in. to	81	ft. and		in. to		ft.	

WELL WATER TO BE USED AS:			
1 Domestic	3 Feedlot	5 Public water supply	8 Air conditioning
2 Irrigation	4 Industrial	6 <u>Oil field water supply</u>	9 Dewatering
		7 <u>Lawn and garden only</u>	10 Observation well
			11 Injection well
			12 Other (Specify below)
			

Was a chemical/bacteriological sample submitted to Department? Yes.....No.....; If yes, mo/day/yr sample was submitted
 Water Well Disinfected? Yes No

5	TYPE OF BLANK CASING USED:		5 Wrought iron	8 Concrete tile	CASING JOINTS: Glued Clamped Welded Threaded
	1 Steel	3 RMP (SR)	6 Asbestos-Cement	9 Other (specify below)	
	2 PVC	4 ABS	7 Fiberglass		

Blank casing diameter 5 in. to 61 ft., Dia. in. to ft., Dia. in. to ft.
Casing height above land surface 12 in. weight 2.8 lbs./ft. Wall thickness or gauge No. Sch. 40

TYPE OF SCREEN OR PERFORATION MATERIAL:			7 <u>PVC</u>	10 Asbestos-cement
1 Steel	3 Stainless steel	5 Fiberglass	8 RMP (SR)	11 Other (specify)
2 Brass	4 Galvanized steel	6 Concrete tile	* 9 ABS	12 None used (open hole)

SCREEN OR PERFORATION OPENINGS ARE:		5 Gauzed wrapped	8 <u>Saw cut</u>	11 None (open hole)
1 Continuous slot	3 Mill slot	6 Wire wrapped	9 Drilled holes	
2 Louvered shutter	4 Key punched	7 Torch cut	10 Other (specify)	

SCREEN-PERFORATED INTERVALS: From 61 ft. to 81 ft., From ft. to ft.
From ft. to ft., From ft. to ft.
GRAVEL PACK INTERVALS: From 10 ft. to 81 ft., From ft. to ft.
From ft. to ft., From ft. to ft.

6	GROUT MATERIAL:	1 Neat cement	2 Cement grout	3 <u>Bentonite</u>	4 Other
	Grout Intervals:	From 0 ft to 10	ft. From	ft to	ft. From ft. to

What is the nearest source of possible contamination:

1 Septic tank	4 Lateral lines	7 Pit privy	10 Livestock pens	14 Abandoned water well
2 Sewer lines	5 Cess pool	8 Sewage lagoon	11 Fuel storage	15 <u>Oil well/Gas well</u>
3 Watertight sewer lines	6 Seepage pit	9 Feedyard	12 Fertilizer storage	16 Other (specify below)
Direction from well?	South		13 Insecticide storage	
			How many feet?	60

[illegible]

7 CONTRACTOR'S OR LANDOWNER'S CERTIFICATION: This water well was (1) constructed, (2) reconstructed, or (3) plugged under my jurisdiction and was completed on (mo/day/year) 7/14/81 and this record is true to the best of my knowledge and belief. Kansas

Water Well Contractor's License No. 186 This Water Well Record was completed on (mo/day/yr) 8/25/81
under the business name of Kellys Water Wells by (signature) [Signature]
INSTRUCTIONS: Use typewriter or ball point pen, PLEASE PRESS FIRMLY and PRINT clearly. Please fill in blanks, underline or circle the correct answers. Send top three copies to Kansas Department of Health and Environment, Division of Environment, Environmental Geology Section, Topeka, KS 66620. Send one to WATER WELL OWNER and retain one for your records.