USE TYPEWRITER OR BALL POINT PEN-PRESS FIRMLY, PRINT CLEARLY.

T	R	EW	sec 1/4	1/4	1/4	No.				

WATER WELL RECORD
KSA 82a-1201-1215

Kansas State Dept. Of Health
(Water Well Contractors)
Forbes-Bldg. 740
Topeka, Kansas 66620

1 Location of well:	County	Township name	Fraction	Section number	Town number	Range number
	Kingman	Peters	SW 1/4	14	29	9

Distance and direction from nearest town or city: 1 mile 1/4 East Willowdale Kansas

Street address of well location if in city:

3 Owner of well: Josephine Arensdorf

Address: ~~Willowdale~~ Spivey Kansas 67142

Locate with "X" in section below: S

Sketch map: COUNTY ROAD N

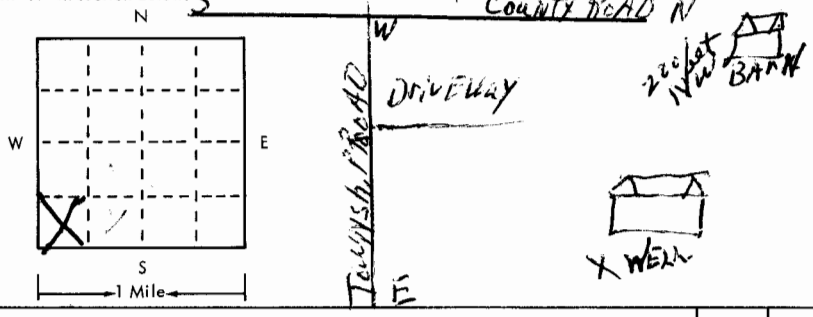

4 Well depth: 40 ft. Date of completion 7-28 75
Well diameter 8 in.

5 ☐ Cable tool ☒ Rotary ☐ Driven ☐ Dug
☐ Hollow rod ☐ Jetted ☐ Bored ☐ Reverse rotary

6 Use: ☒ Domestic ☐ Public supply ☐ Industry
☐ Irrigation ☐ Air conditioning ☐ Commercial
☐ Test well ☐

7 Casing: Material PVC Height: above/below
Threaded ☐ Welded ☐ Surface 24 in.
Diam. Weight lbs./ft.
5 in. to 40 ft. depth Drive shoe? ☐ Yes ☒ No
in. to ft. depth

2 Type and color of material	From	To
Soil	0	1
Sand Brown Fine	1	20
Clay and Solid	20	30
Course Gravel	30	40
Dept of Well		
40" feet"		
Rock Bottom		
(use a second sheet if needed)		

8 Screen:
Manufacturer Jess Lowell
Type PVC Dia.
Slot/gauze 16 Length 10
Set between 30 ft. and 40 ft.
Fittings:
Gravel pack ☒ Yes ☐ No Size range of material 1/4

9 Static water level:
20 ft. below land surface Date 7-28 75

10 Pumping level below land surfaces:
ft. after hrs. pumping g.p.m.
ft. after hrs. pumping g.p.m.
Estimated maximum yield g.p.m.

11 Water sample submitted:
☐ Yes ☒ No Date 7-28 75

12 Well head completion: Well House
☐ Pitless adapter 24 inches above grade

13 Well grouted? ☒ Yes ☐ No
☐ Neat cement ☐ Bentonite ☐
Depth: From 1 ft. to 10 ft.

14 Nearest source of possible contamination:
ft. 200 Direction NW Type BARNYARD
Well disinfected upon completion? ☒ Yes ☐ No

15 Pump: ☐ Not installed
Manufacturer's name NOT INSTALLED
Model number HP Volts
Length of drop pipe ft. capacity g.m.p.
Type:
☐ Submersible ☐ Turbine
☐ Jet ☐ Reciprocating
☐ Certrifugal ☐ Other

16 Remarks: elevation

Topography:
☐ Hill
☐ Slope
☒ Upland
☐ Valley

17 Water well contractor's certification:
This well was drilled under my jurisdiction and this report is true to the best of my knowledge and belief.
WEBER WELL Service
Business name License No.
Address NASHVILLE KANSAS 226
Signed Leon G Weber Date 7-28 75
Authorized representative

Forward the white, blue and pink copies to the Kansas State Dept. Of Health.

Form WWC-5