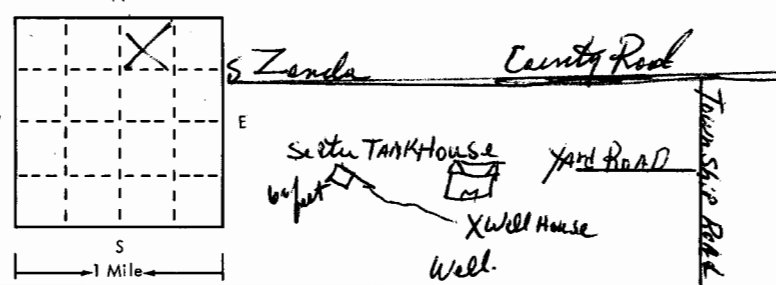


USE TYPEWRITER OR BALL POINT PEN-PRESS FIRMLY, PRINT CLEARLY.

T R EW sec 1/4 1/4 1/4 No.

WATER WELL RECORD
KSA 82a-1201-1215

Kansas State Dept. Of Health
(Water Well Contractors)
Forbes-Bldg. 740
Topeka, Kansas 66620

| | | | | | | |
|---|---------------------------|--------------------------------|---------------------------|---|--------------------------|--------------------------|
| 1 Location of well: | County KINBOGAN | Township name PETERS | Fraction NE 1/4 | Section number 14 | Town number 29 | Range number 9 |
| Distance and direction from nearest town or city: 6 North 1/2 East of Zencla Kansas | | | | 3 Owner of well: PAUL CONRADY Address: KINBOGAN KANSAS 67068 | | |
| Locate with "X" in section below: N  | | | | 4 Well depth: 70 ft. Date of completion 11-17-75 Well diameter 8 in. | | |
| 2 Type and color of material | | | | 5 <input type="checkbox"/> Cable tool <input checked="" type="checkbox"/> Rotary <input type="checkbox"/> Driven <input type="checkbox"/> Dug <input type="checkbox"/> Hollow rod <input type="checkbox"/> Jetted <input type="checkbox"/> Bored <input type="checkbox"/> Reverse rotary | | |
| | | | | 6 Use: <input checked="" type="checkbox"/> Domestic <input type="checkbox"/> Public supply <input type="checkbox"/> Industry <input type="checkbox"/> Irrigation <input type="checkbox"/> Air conditioning <input type="checkbox"/> Commercial <input type="checkbox"/> Test well <input type="checkbox"/> HUMAN | | |
| Soil Brown clay Sand fine Clay Blue centric gravel water sand- | | | | 7 Casing: Material PAVE Height: above/below Threaded <input type="checkbox"/> Welded <input type="checkbox"/> Surface 12 in. Diam. 5 in. to 70 ft. depth Weight 200 lbs./ft. 200 test Drive shoe? <input type="checkbox"/> Yes <input checked="" type="checkbox"/> No | | |
| | | | | 8 Screen: Manufacturer John G. Lowell Type PVC Dia. 5 Slot/gauze 1/16 Length 10 feet Set between 65 ft. and 70 ft. Fittings: Gravel pack <input checked="" type="checkbox"/> Yes <input type="checkbox"/> No Size range of material 1/4 | | |
| 70 feet TOTAL Depth Bottom Red Rock- | | | | 9 Static water level: 55 ft. below land surface Date 11-17-75 | | |
| | | | | 10 Pumping level below land surfaces: ____ ft. after ____ hrs. pumping ____ g.p.m. ____ ft. after N/A pumping ____ g.p.m. Estimated maximum yield ____ g.p.m. | | |
| | | | | 11 Water sample submitted: <input type="checkbox"/> Yes <input checked="" type="checkbox"/> No Date 11-17-75 | | |
| | | | | 12 Well head completion: <input type="checkbox"/> Pitless adapter 12" <input checked="" type="checkbox"/> Inches above grade | | |
| | | | | 13 Well grouted? <input checked="" type="checkbox"/> Yes <input type="checkbox"/> No <input checked="" type="checkbox"/> Neat cement <input type="checkbox"/> Bentonite <input type="checkbox"/> Depth: From 1 ft. to 10 ft. | | |
| | | | | 14 Nearest source of possible contamination: ft. 600 Direction North Type HUMAN Well disinfected upon completion? <input checked="" type="checkbox"/> Yes <input type="checkbox"/> No | | |
| (use a second sheet if needed) | | | | 15 Pump: <input type="checkbox"/> Not installed Manufacturer's name BURKS Jet Pump Model number HV4 HP 1 Volts 230 Length of drop pipe 55 ft. capacity 15 g.m.p. Type: <input type="checkbox"/> Submersible <input type="checkbox"/> Turbine <input checked="" type="checkbox"/> Jet <input type="checkbox"/> Reciprocating <input type="checkbox"/> Centrifugal <input type="checkbox"/> Other | | |
| | | | | 16 Remarks: elevation | | |
| Topography: <input checked="" type="checkbox"/> Hill <input type="checkbox"/> Slope <input type="checkbox"/> Upland <input type="checkbox"/> Valley | | | | 17 Water well contractor's certification: This well was drilled under my jurisdiction and this report is true to the best of my knowledge and belief. Wesley Well Service 226 Business name _____ License No. _____ Address Opashville Kansas Signed Leon A. Wesley Date 11-17-75 Authorized representative | | |

Forward the white, blue and pink copies to the Kansas State Dept. Of Health.

Form WWC-5