


1 LOCATION OF WATER WELL: County: **Kingman** Fraction: **NW 1/4 NE 1/4 NE 1/4** Section Number: **15** Township Number: **T 29 S** Range Number: **R 9W 2E/W**

Distance and direction from nearest town or city street address of well if located within city?
6 Miles North 1/2 Mile West Of Zenda, Kns.

2 WATER WELL OWNER: **Julius Govert**
 RR#, St. Address, Box #: **RT#3** Board of Agriculture, Division of Water Resources
 City, State, ZIP Code: **Kingman, Kansas 67068** Application Number:

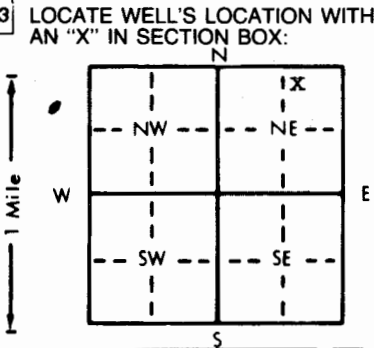

4 DEPTH OF COMPLETED WELL: **73'** ft. ELEVATION: ft.
 Depth(s) Groundwater Encountered 1. **21'** ft. 2. ft. 3. ft.
 WELL'S STATIC WATER LEVEL **19'** ft. below land surface measured on mo/day/yr **Nov 30-90**
 Pump test data: Well water was ft. after hours pumping gpm
 Est. Yield **25** gpm; Well water was **24'** ft. after **1 1/2** hours pumping gpm
 Bore Hole Diameter: **8 3/4** in. to **73'** ft., and in. to ft.
 WELL WATER TO BE USED AS: 5 Public water supply 8 Air conditioning 11 Injection well
 Domestic 3 Feedlot 6 Oil field water supply 9 Dewatering 12 Other (Specify below)
 2 Irrigation 4 Industrial 7 Lawn and garden only 10 Monitoring well
 Was a chemical/bacteriological sample submitted to Department? Yes No If yes, mo/day/yr sample was submitted
 Water Well Disinfected? Yes No

5 TYPE OF BLANK CASING USED:
 1 Steel 3 RMP (SR) 5 Wrought iron 8 Concrete tile CASING JOINTS: Glued Clamped
 2 PVC 4 ABS 6 Asbestos-Cement 9 Other (specify below) Welded
 7 Fiberglass Threaded
 Blank casing diameter **5"** in. to **63'** ft., Dia in. to ft., Dia in. to ft.
 Casing height above land surface **18"** in., weight **160** lbs./ft. Wall thickness or gauge No. **sd r 26**
 TYPE OF SCREEN OR PERFORATION MATERIAL: 7 PVC 10 Asbestos-cement
 1 Steel 3 Stainless steel 5 Fiberglass 8 RMP (SR) 11 Other (specify)
 2 Brass 4 Galvanized steel 6 Concrete tile 9 ABS 12 None used (open hole)
 SCREEN OR PERFORATION OPENINGS ARE:
 1 Continuous slot 3 Mill slot 5 Gauzed wrapped Saw cut 11 None (open hole)
 2 Louvered shutter 4 Key punched 6 Wire wrapped 9 Drilled holes
 7 Torch cut 10 Other (specify)
 SCREEN-PERFORATED INTERVALS: From **73'** ft. to **63'** ft., From ft. to ft.
 From ft. to ft., From ft. to ft.
 GRAVEL PACK INTERVALS: From ft. to ft., From ft. to ft.
 From **73'** ft. to **31'** ft., From ft. to ft.

6 GROUT MATERIAL: Neat cement 2 Cement grout Bentonite 4 Other
 Grout Intervals: From **31'** ft. to **9'** ft., From **9'** ft. to **0'** ft., From ft. to ft.
 What is the nearest source of possible contamination:
 1 Septic tank 4 Lateral lines 7 Pit privy 10 Livestock pens 14 Abandoned water well
 2 Sewer lines 5 Cess pool 8 Sewage lagoon 11 Fuel storage 15 Oil well/Gas well
 3 Watertight sewer lines 6 Seepage pit 9 Feedyard 12 Fertilizer storage 16 Other (specify below)
 13 Insecticide storage
 Direction from well? **North** How many feet? **50'**

FROM	TO	LITHOLOGIC LOG	FROM	TO	PLUGGING INTERVALS
0'	9'	Top Soil			
9'	21'	Sandy Clay .			
21'	24'	Fine sand.			
24'	36'	Brown clay .			
36'	61'	White sandy clay.			
61'	73'	Course sand & Fine gravel. (very clean)			
		Red Bed.			

7 CONTRACTOR'S OR LANDOWNER'S CERTIFICATION: This water well was (1) constructed, (2) reconstructed, or (3) plugged under my jurisdiction and was completed on (mo/day/year) **Nov 30 -90** and this record is true to the best of my knowledge and belief. Kansas Water Well Contractor's License No. **112** This Water Well Record was completed on (mo/day/yr) **Dec. 28 -90** under the business name of **Wells Drilling Co.** by (signature) *Dal Wells*