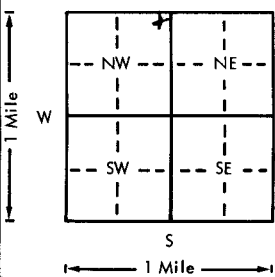
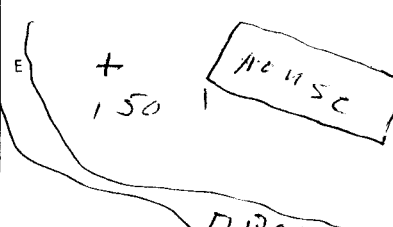


USE-TYPEWRITER OR BALL
POINT PEN-PRESS FIRMLY,
PRINT CLEARLY.

WATER WELL RECORD
KSA 82a-1201-1215

Kansas Department of Health and
Environment-Division of Environment
(Water well Contractors)
Topeka, Kansas 66620

1. Location of well:		County <u>Kingman</u>	Fraction <u>Ne 1/4 Ne 1/4 Twp 1/4</u>	Section number <u>8 16</u>	Township number <u>T 28</u>	Range number <u>S R 9 E 10</u>
2. Distance and direction from nearest town or city: Street address of well location if in city: <u>2 w 2nd Milldale</u>		3. Owner of well: <u>Leonard Henning</u> R.R. or street: City, state, zip code: <u>Spivey, Mo.</u>				
4. Locate with "X" in section below: 		Sketch map: 				
5. Type and color of material		From		To		6. Bore hole dia. <u>8</u> in. Completion date <u>9-12-78</u> Well depth <u>85</u> ft.
soil		0		2		7. <input checked="" type="checkbox"/> Cable tool <input checked="" type="checkbox"/> Rotary <input type="checkbox"/> Driven <input type="checkbox"/> Dug <input type="checkbox"/> Hollow rod <input type="checkbox"/> Jetted <input type="checkbox"/> Bored <input type="checkbox"/> Reverse rotary
clay		2		15		8. Use: <input checked="" type="checkbox"/> Domestic <input type="checkbox"/> Public supply <input type="checkbox"/> Industry <input type="checkbox"/> Irrigation <input type="checkbox"/> Air conditioning <input type="checkbox"/> Stock <input type="checkbox"/> Lawn <input type="checkbox"/> Oil field water <input type="checkbox"/> Other
red sand w/ clay lenses		15		40		9. Casing: Material <input type="checkbox"/> Threaded <input type="checkbox"/> Welded <input type="checkbox"/> Surface <input checked="" type="checkbox"/> RMP <input type="checkbox"/> PVC <input type="checkbox"/> Weight <u>8.29</u> lbs./ft. Dia. <u>8</u> in. to <u>8.5</u> ft. depth Wall Thickness: inches or Dia. <u>8</u> in. to <u>8.5</u> ft. depth gage No. <u>258</u>
clay		40		56		10. Screen: Manufacturer's name <u>Lyman</u> Type <u>pvc</u> Dia. <u>5</u> Slot/gauze <u>0.30</u> Length <u>16</u> Set between <u>73</u> ft. and <u>88</u> ft. Set between <u>88</u> ft. and <u>100</u> ft. Gravel pack? <input checked="" type="checkbox"/> Size range of material <u>20</u>
red sand		56		80		11. Static water level: <u>27</u> ft. below land surface Date <u>6-12-78</u>
clay		80		84		12. Pumping level below land surfaces: ____ ft. after ____ hrs. pumping ____ g.p.m. ____ ft. after ____ hrs. pumping ____ g.p.m. Estimated maximum yield <u>40</u> g.p.m.
(Use a second sheet if needed)						13. Water sample submitted: ____ mo./day/yr. Yes <input checked="" type="checkbox"/> No <input type="checkbox"/> Date ____
						14. Well head completion: <input checked="" type="checkbox"/> Pitless adapter <u>12</u> inches above grade
						15. Well grouted? <input checked="" type="checkbox"/> With: <input checked="" type="checkbox"/> Neat cement <input type="checkbox"/> Bentonite <input type="checkbox"/> Concrete Depth: From <u>15</u> ft. to <u>5</u> ft. <u>5</u>
						16. Nearest source of possible contamination: ft. <u>150</u> Direction <u>D</u> Type <u>septic</u> Well disinfected upon completion? <input checked="" type="checkbox"/> Yes <input type="checkbox"/> No
						17. Pump: <input checked="" type="checkbox"/> Not installed Manufacturer's name <u>Jacuzzi</u> Model number <u>5543</u> HP <u>1</u> Volts <u>230</u> Length of drop pipe <u>63</u> ft. Capacity <u>16</u> g.p.m. Type: <input checked="" type="checkbox"/> Submersible <input type="checkbox"/> Turbine <input type="checkbox"/> Jet <input type="checkbox"/> Reciprocating <input type="checkbox"/> Centrifugal <input type="checkbox"/> Other
18. Elevation:	19. Remarks: <u>customer to pour slab</u>					20. Water well contractor's certification: This well was drilled under my jurisdiction and this report is true to the best of my knowledge and belief. <u>Lyman Bros.</u> <u>140</u> Business name License No. Address <u>ML</u> Signed <u>W.A. Lyman</u> Date <u>7-2-78</u> Authorized representative