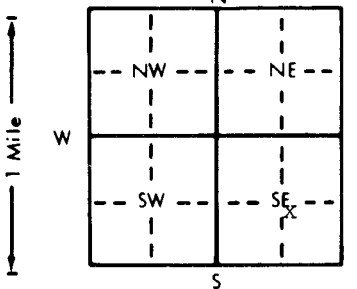


1 LOCATION OF WATER WELL:		Fraction	Section Number	Township Number	Range Number
County: KINGMAN		NW 1/4 SE 1/4 SE 1/4	25	T 29 S	R 9 E/W
Distance and direction from nearest town or city street address of well if located within city? 3-N 2-E. OF ZENDA, KS.					
2 WATER WELL OWNER: EDMONSTON OIL CO. RR#, St. Address, Box # : 125 N. MARKET #1260 City, State, ZIP Code : WICHITA, KS. 67202 Board of Agriculture, Division of Water Resources Application Number: 94-0411					
3 LOCATE WELL'S LOCATION WITH AN "X" IN SECTION BOX:		4 DEPTH OF COMPLETED WELL: 52 ft. ELEVATION:			
		Depth(s) Groundwater Encountered 1. ft. 2. ft. 3. ft. WELL'S STATIC WATER LEVEL 19 ft. below land surface measured on mo/day/yr Pump test data: Well water was ft. after hours pumping gpm Est. Yield gpm: Well water was ft. after hours pumping gpm Bore Hole Diameter 9 in. to ft. and in. to ft. WELL WATER TO BE USED AS: 5 Public water supply 8 Air conditioning 11 Injection well 1 Domestic 3 Feedlot 10 Oil field water supply 9 Dewatering 12 Other (Specify below) 2 Irrigation 4 Industrial 7 Lawn and garden only 10 Monitoring well Was a chemical/bacteriological sample submitted to Department? Yes No X; If yes, mo/day/yr sample was submitted Water Well Disinfected? Yes X No			
5 TYPE OF BLANK CASING USED:		CASING JOINTS: Glued X Clamped			
1 Steel 3 RMP (SR) 5 Wrought iron 8 Concrete tile X PVC 4 ABS 6 Asbestos-Cement 9 Other (specify below) Welded 7 Fiberglass Threaded					
Blank casing diameter 5 in. to 42 ft. Dia in. to ft. Dia in. to ft. Casing height above land surface 12 in. weight lbs./ft. Wall thickness or gauge No.					
TYPE OF SCREEN OR PERFORATION MATERIAL:		X PVC 10 Asbestos-cement			
1 Steel 3 Stainless steel 5 Fiberglass 8 RMP (SR) 11 Other (specify) 2 Brass 4 Galvanized steel 6 Concrete tile 9 ABS 12 None used (open hole)					
SCREEN OR PERFORATION OPENINGS ARE:		5 Gauzed wrapped 8 Saw cut 11 None (open hole)			
1 Continuous slot X 3 Mill slot 6 Wire wrapped 9 Drilled holes 2 Louvered shutter 4 Key punched 7 Torch cut 10 Other (specify)					
SCREEN-PERFORATED INTERVALS: From 42 ft. to 52 ft. From ft. to ft. From ft. to ft. From ft. to ft.					
GRAVEL PACK INTERVALS: From 20 ft. to 52 ft. From ft. to ft. From ft. to ft. From ft. to ft.					
6 GROUT MATERIAL: 1 Neat cement 2 Cement grout X Bentonite 4 Other					
Grout Intervals: From 0 ft. to 20 ft. From ft. to ft. From ft. to ft.					
What is the nearest source of possible contamination:		10 Livestock pens 14 Abandoned water well			
1 Septic tank 4 Lateral lines 7 Pit privy 11 Fuel storage 15 Oil well/Gas well 2 Sewer lines 5 Cess pool 8 Sewage lagoon 12 Fertilizer storage 16 Other (specify below) 3 Watertight sewer lines 6 Seepage pit 9 Feedyard 13 Insecticide storage NONE KNOWN					
Direction from well?		How many feet?			
FROM	TO	LITHOLOGIC LOG	FROM	TO	PLUGGING INTERVALS
0	3	TOP SOIL			
3	15	CLAY			
15	52	GRAVEL			
7 CONTRACTOR'S OR LANDOWNER'S CERTIFICATION: This water well was (1) constructed, (2) reconstructed, or (3) plugged under my jurisdiction and was completed on (mo/day/year) 10-22-94 and this record is true to the best of my knowledge and belief. Kansas Water Well Contractor's License No. 462 This Water Well Record was completed on (mo/day/yr) 10-23-94 under the business name of SAM'S WATER WELL SERVICE by (signature) 