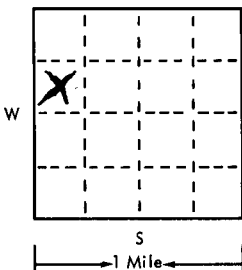
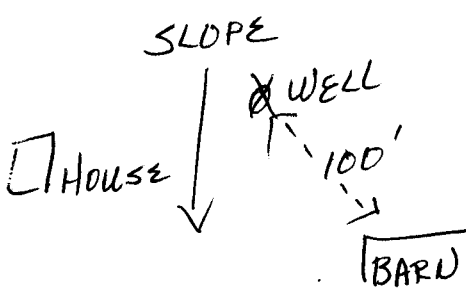


USE TYPEWRITER OR BALL  
POINT PEN-PRESS FIRMLY,  
PRINT CLEARLY.

WATER WELL RECORD  
KSA 82a-1201-1215

T R EW sec 1/4 1/4 1/4 No.

Kansas State Dept. Of Health  
(Water Well Contractors)  
Forbes-Bldg. 740  
Topeka, Kansas 66620

1 Location of well:	County <b>REPUBLIC</b>	Township name	Fraction <b>NW 1/4</b>	Section number <b>18</b>	Town number <b>T 2</b>	Range number <b>R 1</b>		
Distance and direction from nearest town or city: <b>6 1/2 MILES</b>			3 Owner of well: <b>EUGENE PETERS</b>					
Street address of well location if in city:			Address: <b>CUBA KANS</b>					
Locate with "X" in section below: 			Sketch map: 			4 Well depth: <b>178</b> ft. Date of completion <b>2-26-75</b> Well diameter <b>8</b> in.		
2			Type and color of material		From To		5 <input type="checkbox"/> Cable tool <input checked="" type="checkbox"/> Rotary <input type="checkbox"/> Driven <input type="checkbox"/> Dug <input type="checkbox"/> Hollow rod <input type="checkbox"/> Jetted <input type="checkbox"/> Bored <input type="checkbox"/> Reverse rotary	
							6 Use: <input checked="" type="checkbox"/> Domestic <input type="checkbox"/> Public supply <input type="checkbox"/> Industry <input type="checkbox"/> Irrigation <input type="checkbox"/> Air conditioning <input type="checkbox"/> Commercial <input type="checkbox"/> Test well <input type="checkbox"/>	
							7 Casing: Material <b>PVC</b> Height: above/below Threaded <input type="checkbox"/> Welded <input checked="" type="checkbox"/> Surface <b>24</b> in. Diam. <b>3</b> lbs./ft. Weight <b>3</b> lbs./ft. <b>13</b> in. to <b>178</b> ft. depth Drive shoe? <input type="checkbox"/> Yes <input checked="" type="checkbox"/> No in. to in. ft. depth	
							8 Screen: Manufacturer <b>JESS + LOWELL</b> Type <b>PLASTIC P.V.C. 5"</b> Slot gauge <b>5/16</b> Length <b>20'</b> Set between <b>178</b> ft. and <b>158</b> ft. Fittings: Gravel pack <input checked="" type="checkbox"/> Yes <input type="checkbox"/> No Size range of material <b>1/4 - 1/2</b>	
							9 Static water level: <b>100</b> ft. below land surface Date <b>2/26/75</b>	
							10 Pumping level below land surfaces: <b>NA</b> ft. after <b>NA</b> hrs. pumping <b>NA</b> g.p.m. <b>NA</b> ft. after <b>NA</b> hrs. pumping <b>NA</b> g.p.m. Estimated maximum yield <b>30</b> g.p.m.	
							11 Water sample submitted: <input type="checkbox"/> Yes <input checked="" type="checkbox"/> No Date	
							12 Well head completion: <input type="checkbox"/> Pitless adapter <input checked="" type="checkbox"/> Inches above grade	
							13 Well grouted? <input checked="" type="checkbox"/> Yes <input type="checkbox"/> No <input checked="" type="checkbox"/> Neat cement <input type="checkbox"/> Bentonite <input type="checkbox"/> Depth: From <b>3</b> ft. to <b>12</b> ft.	
							14 Nearest source of possible contamination: ft. <b>100</b> Direction <b>SE</b> Type <b>Exp Lot</b> Well disinfected upon completion? <input checked="" type="checkbox"/> Yes <input type="checkbox"/> No	
							15 Pump: <input checked="" type="checkbox"/> Not installed Manufacturer's name Model number HP Volts Length of drop pipe ft. capacity g.p.m. Type: <input type="checkbox"/> Submersible <input type="checkbox"/> Turbine <input type="checkbox"/> Jet <input type="checkbox"/> Reciprocating <input type="checkbox"/> Centrifugal <input type="checkbox"/> Other	
							16 Remarks: elevation <b>1530'</b> <b>WELL DRILLED ON HILLY FARMSTEAD WITH FAST DRAINAGE</b> Topography: <input type="checkbox"/> Hill <input checked="" type="checkbox"/> Slope <input type="checkbox"/> Upland <input type="checkbox"/> Valley	
							17 Water well contractor's certification: This well was drilled under my jurisdiction and this report is true to the best of my knowledge and belief. <b>Geo Cox &amp; Sons Inc</b> Business name License No. Address <b>Eggleston, Kans</b> Signed <b>George Cox</b> Date <b>2-28-75</b> Authorized representative	