


1 LOCATION OF WATER WELL: Fraction NW 1/4 SW 1/4 SW 1/4 Section Number 1 Township Number T 2 S Range Number R 15 E
 County: Brown

Distance and direction from nearest town or city street address of well if located within city?

1 3/4 mi. south from Morrill, KS.

2 WATER WELL OWNER: Wayne Grimm
 RR#, St. Address, Box #: 2722 Dewberry Rd. Board of Agriculture, Division of Water Resources
 City, State, ZIP Code: Morrill, KS, 66515 Application Number:

3 LOCATE WELL'S LOCATION WITH AN "X" IN SECTION BOX: 4 DEPTH OF COMPLETED WELL 120 1/2 ft. ELEVATION:

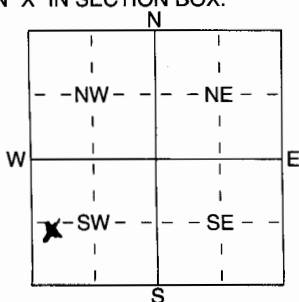

Depth(s) Groundwater Encountered 1 40 ft. 2 81 ft. 3 109 1/2 ft.
 WELL'S STATIC WATER LEVEL 81 ft. below land surface measured on mo/day/yr 6-24-05
 Pump test data: Well water was _____ ft. after _____ hours pumping _____ gpm
 Est. Yield 40+ gpm: Well water was _____ ft. after _____ hours pumping _____ gpm
 WELL WATER TO BE USED AS:
 1 Domestic 3 Feedlot 5 Public water supply 8 Air conditioning 11 Injection well
 2 Irrigation 4 Industrial 6 Oil field water supply 9 Dewatering 12 Other (Specify below)
 7 Domestic (lawn & garden) 10 Monitoring well

Was a chemical/bacteriological sample submitted to Department? Yes _____ No X; If yes, mo/day/yr sample was submitted
 Water Well Disinfected? Yes _____ No X

5 TYPE OF BLANK CASING USED: 1 Steel 3 RMP (SR) 5 Wrought iron 8 Concrete tile CASING JOINTS: Glued X Clamped _____
2 PVC 4 ABS 6 Asbestos-Cement 9 Other (specify below) Welded X screws
 7 Fiberglass _____ Threaded _____

Blank casing diameter 5 in. to 100 1/2 ft., Dia _____ in. to _____ ft., Dia _____ in. to _____ ft.
 Casing height above land surface 20 in., weight _____ lbs./ft. Wall thickness or gauge No. SDR 21

TYPE OF SCREEN OR PERFORATION MATERIAL:
 1 Steel 3 Stainless Steel 5 Fiberglass 7 PVC 10 Asbestos-Cement
 2 Brass 4 Galvanized Steel 6 Concrete tile 8 RMP (SR) 11 Other (Specify) _____
 9 ABS 12 None used (open hole)

SCREEN OR PERFORATION OPENINGS ARE:
 1 Continuous slot 3 Mill slot .030" 5 Gauzed wrapped 8 Saw cut 11 None (open hole)
 2 Louvered shutter 4 Key punched 6 Wire wrapped 9 Drilled holes
 7 Torch cut 10 Other (specify) _____ ft.

SCREEN-PERFORATED INTERVALS: From 100 1/2 ft. to 120 1/2 ft., From _____ ft. to _____ ft.
 From _____ ft. to _____ ft., From _____ ft. to _____ ft.
 GRAVEL PACK INTERVALS: From 23 ft. to 120 1/2 ft., From _____ ft. to _____ ft.
 From _____ ft. to _____ ft., From _____ ft. to _____ ft.

6 GROUT MATERIAL: 1 Neat cement 2 Cement grout 3 Bentonite 4 Other _____
 Grout Intervals: From 8 ft. to 23 ft., From _____ ft. to _____ ft., From _____ ft. to _____ ft.

What is the nearest source of possible contamination:
 1 Septic tank 4 Lateral lines 7 Pit privy 10 Livestock pens 14 Abandoned water well
 2 Sewer lines 5 Cess pool 8 Sewage lagoon 11 Fuel storage 15 Oil well/Gas well
 3 Watertight sewer lines 6 Seepage pit 9 Feedyard 12 Fertilizer storage 16 Other (specify below)
 13 Insecticide storage _____

Direction from well? _____ How many feet? _____

FROM	TO	LITHOLOGIC LOG	FROM	TO	PLUGGING INTERVALS
0	2	fill dirt - brown	75	79	shale - gray to green
2	6	topsoil - black	79	89	Shaley limestone - gray to lt. green
6	10	clay - tan	89	93	Shale - gray/green to red
10	26	Sandy clay - yellow	93	99	Shaley limestone - gray to tan
26	31	Shale - red, gravel - yellow to tan	99	101	limestone - gray to tan, Shale - black
31	37	Shale - red, limestone - gray	101	110	Shale - black
37	38	limestone - tan to gray	110	120 1/2	Chert & limestone - gray
38	41	limestone - gray			sandstone - rust
41	44	Shale & limestone - brown			Shale - black
44	50	Shale - black			
50	62	Shaley limestone - tan			
62	65	Shale - gray			
65	69	Shaley limestone - tan to gray			
69	75	Shaley limestone - tan			

7 CONTRACTOR'S OR LANDOWNER'S CERTIFICATION: This water well was (1) constructed, (2) reconstructed, or (3) plugged under my jurisdiction and was completed on (mo/day/year) 6-24-05 and this record is true to the best of my knowledge and belief. Kansas Water Well Contractor's Licence No 627 This Water Well Record was completed on (mo/day/yr) 6-28-05 under the business name of Meyer Well Drilling by (signature) Steven E. Meyer