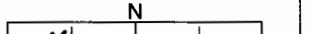


1	LOCATION OF WATER WELL:	Fraction	Section Number	Township Number	Range Number
County:	<i>Phillips</i>	<i>NE</i> $\frac{1}{4}$ <i>NW</i> $\frac{1}{4}$ <i>NW</i> $\frac{1}{4}$	<i>32</i>	T <i>2</i> S	R <i>17</i> E <i>1</i>

Distance and direction from nearest town or city street address of well if located within city?  
2 miles east - 6 miles north - 1/4 east on E Limestone Rd in Phillips County

2 WATER WELL OWNER: Kenneth Johnson  
 RR#, St. Address, Box # : E Limestone Rd  
 City, State, ZIP Code : Phillipsburg, KS 67461

Board of Agriculture, Division of Water Resources  
 Application Number:

<p>3 LOCATE WELL'S LOCATION WITH AN "X" IN SECTION BOX:</p> <div style="text-align: center;">  </div>	<p>4 DEPTH OF COMPLETED WELL <u>1</u> ft. ELEVATION: _____</p> <p>Depth(s) Groundwater Encountered <u>1</u> ft. <u>26</u> ft. 3 _____ ft.</p> <p>WELL'S STATIC WATER LEVEL <u>26</u> ft. below land surface measured on mo/day/yr <u>11-6-06</u></p> <p>Pump test data: Well water was _____ ft. after _____ hours pumping _____ gpm</p> <p>Est. Yield <u>5</u> gpm: Well water was _____ ft. after _____ hours pumping _____ gpm</p> <p>WELL WATER TO BE USED AS:</p> <table style="width: 100%;"> <tr> <td>5 Public water supply</td> <td>8 Air conditioning</td> <td>11 Injection well</td> </tr> <tr> <td>1 Domestic</td> <td>6 Oil field water supply</td> <td>9 Dewatering</td> </tr> <tr> <td>2 Irrigation</td> <td>4 Industrial</td> <td>7 Domestic (lawn &amp; garden)</td> </tr> <tr> <td></td> <td></td> <td>10 Monitoring well</td> </tr> </table> <p>Was a chemical/bacteriological sample submitted to Department? Yes _____ No _____; If yes, mo/day/yr sample was submitted _____</p> <p style="text-align: right;">Water Well Disinfected? <u>Yes</u> No</p>	5 Public water supply	8 Air conditioning	11 Injection well	1 Domestic	6 Oil field water supply	9 Dewatering	2 Irrigation	4 Industrial	7 Domestic (lawn & garden)			10 Monitoring well
5 Public water supply	8 Air conditioning	11 Injection well											
1 Domestic	6 Oil field water supply	9 Dewatering											
2 Irrigation	4 Industrial	7 Domestic (lawn & garden)											
		10 Monitoring well											

5 TYPE OF BLANK CASING USED:		3 Wrought iron	8 Concrete tile	CASING JOINTS: Glued <input checked="" type="checkbox"/> Clamped <input type="checkbox"/>	
1 Steel	3 RMP (SR)	6 Asbestos-Cement	9 Other (specify below)	Welded <input type="checkbox"/>	
2 PVC	4 ABS	7 Fiberglass		Threaded <input type="checkbox"/>	
Blank casing diameter <u>5</u> in. to <u>31</u> ft., Dia				in. to <u>160</u> ft., Dia	
Casing height above land surface <u>24</u> in., weight				lbs./ft. Wall thickness or gauge No.	
TYPE OF SCREEN OR PERFORATION MATERIAL:					
1 Steel	3 Stainless Steel	5 Fiberglass	8 RMP (SR)	10 Asbestos-Cement	
2 Brass	4 Galvanized Steel	6 Concrete tile	9 ABS	11 Other (Specify)	
				12 None used (open hole)	
SCREEN OR PERFORATION OPENINGS ARE:					
1 Continuous slot	3 Mill slot	5 Gauzed wrapped	8 Saw cut	11 None (open hole)	
2 Louvered shutter	4 Key punched	6 Wire wrapped	9 Drilled holes		
		7 Torch cut	10 Other (specify)		

6 GROUT MATERIAL: 1 Neat cement 2 Cement grout 3 Bentonite 4 Other .....  
Grout Intervals: From 20 ft. to 0 ft., From ..... ft. to ..... ft., From ..... ft. to ..... ft.  
What is the nearest source of possible contamination:  
1 Septic tank 4 Lateral lines 7 Pit privy 10 Livestock pens 14 Abandoned water well  
2 Sewer lines 5 Cess pool 8 Sewage lagoon 11 Fuel storage 15 Oil well/Gas well  
3 Watertight sewer lines 6 Seepage pit 9 Feedyard 12 Fertilizer storage 16 Other (specify below)  
13 Insecticide storage .....  
Direction from well? West How many feet? 1000

[illegible]

7 CONTRACTOR'S OR LANDOWNER'S CERTIFICATION: This water well was (1) constructed, (2) reconstructed, or (3) plugged under my jurisdiction and was completed on (mo/day/year) 11-2-06 and this record is true to the best of my knowledge and belief. Kansas Water Well Contractor's Licence No. 738 This Water Well Record was completed on (mo/day/yr) 11-2-06 under the business name of Refinace Well Service by (signature) [Signature]