


WATER WELL PLUGGING RECORD Form WWC-5P
KSA 82a-1212
ID NO.
MW-5

1 LOCATION OF WATER WELL: County: Brown	Fraction NW ¼ NW¼ NW ¼ NW ¼	Section Number 28	Township Number T 2 S	Range Number 17 <input checked="" type="checkbox"/> E <input type="checkbox"/> W	
Street/Rural Address of Well Location; if unknown, distance & direction from nearest town or intersection: If at owner's address, check here <input checked="" type="checkbox"/> 205 N. 1st Street Hiawatha, KS 66434		Global Positioning Systems (GPS) information: Latitude: 39.8546 (in decimal degrees) Longitude: 95.5264 (in decimal degrees) Elevation: 1103.11 TOC Horizontal Datum: <input type="checkbox"/> WGS84, <input type="checkbox"/> NAD83, <input checked="" type="checkbox"/> NAD27 Collection Method:	
2 WATER WELL OWNER: NEK Subway, Inc. RR#, St. Address, Box #: 205 N. 1st City, State ZIP Code: Hiawatha, KS 66434		<input type="checkbox"/> GPS unit (Make/Model: _____) <input checked="" type="checkbox"/> Digital Map/Photo, <input type="checkbox"/> Topographic Map, <input checked="" type="checkbox"/> Land Survey Est. Accuracy: <input type="checkbox"/> < 3 m, <input checked="" type="checkbox"/> 3-5 m, <input type="checkbox"/> 5-15 m, <input type="checkbox"/> > 15 m	
3 MARK WELL'S LOCATION WITH AN "X" IN SECTION BOX: <div style="text-align: center;"> </div>	4 DEPTH OF WELL 31.71 ft. WELL'S STATIC WATER LEVEL 20.85 ft WELL WAS USED AS: <div style="display: flex; justify-content: space-between;"> <div> <input type="checkbox"/> Domestic <input type="checkbox"/> Irrigation <input type="checkbox"/> Feedlot <input type="checkbox"/> Industrial </div> <div> <input type="checkbox"/> Public Water Supply <input type="checkbox"/> Oil Field Water Supply <input type="checkbox"/> Domestic (Lawn & Garden) <input type="checkbox"/> Air Conditioning </div> <div> <input type="checkbox"/> Dewatering <input checked="" type="checkbox"/> Monitoring <input type="checkbox"/> Injection Well <input type="checkbox"/> Other _____ </div> </div> Was a chemical/bacteriological sample submitted to Department? Yes <input type="checkbox"/> No <input checked="" type="checkbox"/>	
5 TYPE OF BLANK CASING USED: <div style="display: flex; justify-content: space-between;"> <div> <input type="checkbox"/> Steel <input checked="" type="checkbox"/> PVC </div> <div> <input type="checkbox"/> RMP (SR) <input type="checkbox"/> ABS </div> <div> <input type="checkbox"/> Wrought <input type="checkbox"/> Asbestos-Cement </div> <div> <input type="checkbox"/> Fiberglass <input type="checkbox"/> Concrete Tile </div> <div> <input type="checkbox"/> Other (Specify below) _____ </div> </div> Blank casing diameter 2 in. Was casing pulled? Yes <input checked="" type="checkbox"/> No <input type="checkbox"/> If yes, how much 3 ft Casing height above or below land surface 36 in.	
6 GROUT PLUG MATERIAL: <input type="checkbox"/> Neat cement <input type="checkbox"/> Cement grout <input checked="" type="checkbox"/> Bentonite <input type="checkbox"/> Other _____ Grout Plug Intervals: From 3 ft. to 31.71 ft., From _____ ft. to _____ ft., From _____ ft. to _____ ft. What is the nearest source of possible contamination: <div style="display: flex; justify-content: space-between;"> <div> <input type="checkbox"/> Septic tank <input checked="" type="checkbox"/> Sewer lines <input type="checkbox"/> Watertight sewer lines <input type="checkbox"/> Lateral lines <input type="checkbox"/> Cess pool </div> <div> <input type="checkbox"/> Seepage pit <input type="checkbox"/> Pit privy <input type="checkbox"/> Sewage lagoon <input type="checkbox"/> Feedyard <input type="checkbox"/> Livestock pens </div> <div> <input type="checkbox"/> Fuel storage <input type="checkbox"/> Fertilizer storage <input type="checkbox"/> Insecticide storage <input type="checkbox"/> Abandoned water well <input type="checkbox"/> Oil well/Gas well </div> <div> <input type="checkbox"/> Other (specify below) _____ Direction from well? 200 ft How many feet? South </div> </div> <table border="1" style="width:100%; border-collapse: collapse; margin-top: 10px;"> <thead> <tr> <th>FROM</th> <th>TO</th> <th>PLUGGING MATERIALS</th> <th>FROM</th> <th>TO</th> <th>PLUGGING MATERIALS</th> </tr> </thead> <tbody> <tr> <td>0</td> <td>0.5</td> <td>Gravel</td> <td></td> <td></td> <td></td> </tr> <tr> <td>0.5</td> <td>3</td> <td>Compacted silt/clay</td> <td></td> <td></td> <td></td> </tr> <tr> <td>3</td> <td>31.71</td> <td>Hydrated Bentonite chips</td> <td></td> <td></td> <td>U4-007-10522</td> </tr> <tr> <td>31.71</td> <td></td> <td>TD</td> <td></td> <td></td> <td></td> </tr> <tr> <td></td> <td></td> <td></td> <td></td> <td></td> <td></td> </tr> <tr> <td></td> <td></td> <td></td> <td></td> <td></td> <td></td> </tr> <tr> <td></td> <td></td> <td></td> <td></td> <td></td> <td></td> </tr> </tbody> </table>					FROM	TO	PLUGGING MATERIALS	FROM	TO	PLUGGING MATERIALS	0	0.5	Gravel				0.5	3	Compacted silt/clay				3	31.71	Hydrated Bentonite chips			U4-007-10522	31.71		TD																					
FROM	TO	PLUGGING MATERIALS	FROM	TO	PLUGGING MATERIALS	
0	0.5	Gravel	
0.5	3	Compacted silt/clay	
3	31.71	Hydrated Bentonite chips			U4-007-10522	
31.71		TD	
7 CONTRACTOR'S OR LANDOWNER'S CERTIFICATION: This water well was plugged under my jurisdiction and was completed on (mo/day/year) 9-24-18 and this record is true to the best of my knowledge and belief. Kansas Water Well Contractor's License No. 585 . This Water Well Record was completed on (mo/day/year) 10-1-18 under the business name of Associated Environmental, Inc. by (signature)	
Send one white copy to Kansas Department of Health & Environment, Geology Section, 1000 SW Jackson Street, Ste. 420, Topeka, KS 66612-1367. Send one copy to WATER WELL OWNER and retain one for your records. Visit us at http://www.kdheks.gov/waterwell/index.html Telephone 785-296-5524.	


KSA82a-1212
Revised 1/20/2015

NEE ST

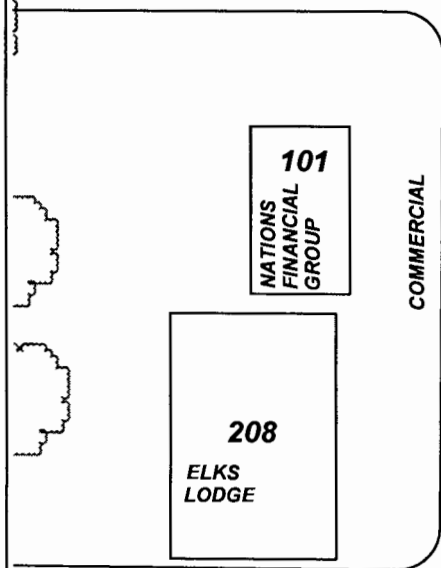

N 1ST ST

ARE ST

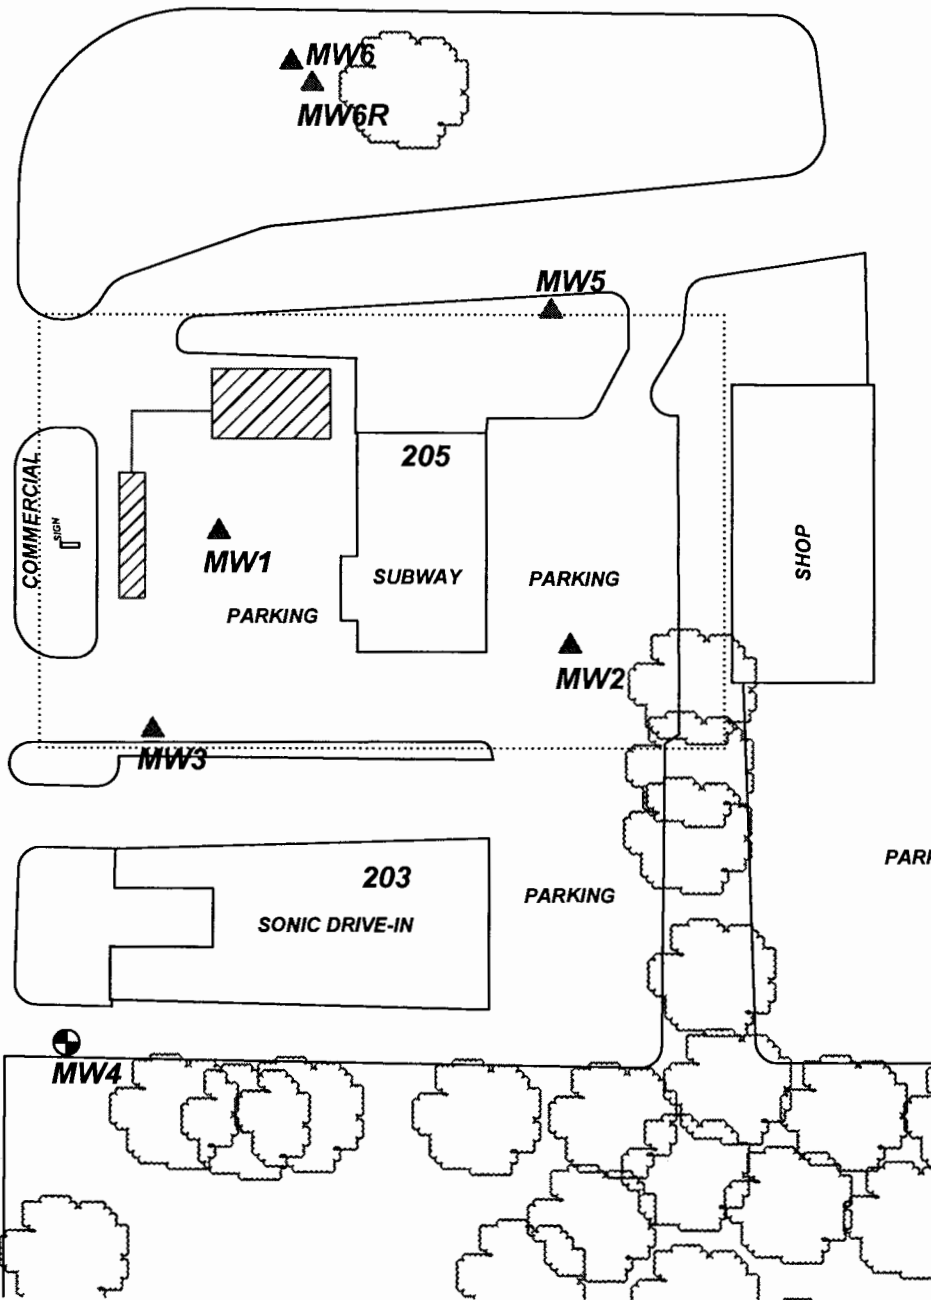

PROJECT: **HIAWATHA STOP 2 SHOP**

ADDRESS: **205 N. 1ST ST.**

LOCATION: **HIAWATHA, KS**

DRAWN BY: **C. ROE** DATE: **2/23/18**

REVISED BY: **S. JOHNSON** DATE: **7/20/18**

AEI JOB #: **TF231** KDHE JOB #: **U4-007-10522**

TITLE:

**FIGURE 2.3
AREA BASE MAP
CLOSE-UP**



**ASSOCIATED
ENVIRONMENTAL
INC.**


LEGEND:

- = FORMER UST BASIN/
PRODUCT LINES/DISPENSERS
- = MONITORING WELL
- = PLUGGED/DESTROYED WELL

..... = SUBJECT PROPERTY



SCALE: **1" = 50'**

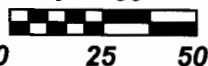

NOTES: