


1 LOCATION OF WATER WELL: County: Phillips Fraction: NW 1/4 NE 1/4 NW 1/4 Section Number: 5 Township Number: T 2 S Range Number: R 18 EW

Distance and direction from nearest town or city street address of well if located within city?
From Woodruff, Ks. - 5 miles South, 2 1/4 miles East, South Side of Road

2 WATER WELL OWNER: CHARLES GEBHARD
 RR#, St. Address, Box #: 248 Highway 383 Board of Agriculture, Division of Water Resources
 City, State, ZIP Code: Phillipsburg, KS 67661-8716 Application Number:

3 LOCATE WELL'S LOCATION WITH AN "X" IN SECTION BOX: 4 DEPTH OF COMPLETED WELL: 104 ft. ELEVATION:

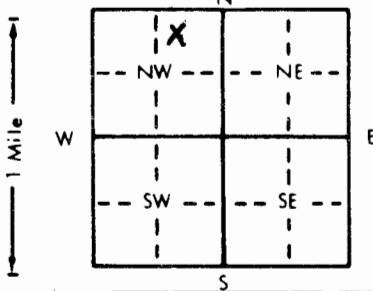

Depth(s) Groundwater Encountered 1. ft. 2. ft. 3. ft.
 WELL'S STATIC WATER LEVEL ft. below land surface measured on mo/day/yr
 Pump test data: Well water was ft. after hours pumping gpm
 Est. Yield 3 gpm: Well water was ft. after hours pumping gpm
 Bore Hole Diameter: 10 in. to 104 ft., and in. to ft.
 WELL WATER TO BE USED AS: 5 Public water supply 8 Air conditioning 11 Injection well
 1 Domestic 3 Feedlot 6 Oil field water supply 9 Dewatering 12 Other (Specify below)
 2 Irrigation 4 Industrial 7 Lawn and garden only 10 Monitoring well
 Was a chemical/bacteriological sample submitted to Department? Yes No X If yes, mo/day/yr sample was submitted
 Water Well Disinfected? Yes X No

5 TYPE OF BLANK CASING USED: 5 Wrought iron 8 Concrete tile CASING JOINTS: Glued X Clamped
 1 Steel 3 RMP (SR) 6 Asbestos-Cement 9 Other (specify below) Welded
2 PVC 4 ABS 7 Fiberglass Threaded
 Blank casing diameter 4 1/2 in. to 104 ft., Dia in. to ft., Dia in. to ft.
 Casing height above land surface: 24 in., weight lbs./ft. Wall thickness or gauge No. .25

TYPE OF SCREEN OR PERFORATION MATERIAL: 7 PVC 10 Asbestos-cement
 1 Steel 3 Stainless steel 5 Fiberglass 8 RMP (SR) 11 Other (specify)
 2 Brass 4 Galvanized steel 6 Concrete tile 9 ABS 12 None used (open hole)

SCREEN OR PERFORATION OPENINGS ARE: 5 Gauzed wrapped 8 Saw cut 11 None (open hole)
 1 Continuous slot 3 Mill slot 6 Wire wrapped 9 Drilled holes
 2 Louvered shutter 4 Key punched 7 Torch cut 10 Other (specify)

SCREEN-PERFORATED INTERVALS: From 84 ft. to 104 ft., From ft. to ft.
 From ft. to ft., From ft. to ft.
 GRAVEL PACK INTERVALS: From 0 ft. to 5 ft., From 25 ft. to 104 ft.
 From ft. to ft., From ft. to ft.

6 GROUT MATERIAL: 1 Neat cement 2 Cement grout 3 Bentonite 4 Other
 Grout Intervals: From 5 ft. to 25 ft., From ft. to ft., From ft. to ft.

What is the nearest source of possible contamination:
 1 Septic tank 4 Lateral lines 7 Pit privy 10 Livestock pens 14 Abandoned water well
 2 Sewer lines 5 Cess pool 8 Sewage lagoon 11 Fuel storage 15 Oil well/Gas well
 3 Watertight sewer lines 6 Seepage pit 9 Feedyard 12 Fertilizer storage 16 Other (specify below)
 13 Insecticide storage
 Direction from well? Southeast How many feet? 1,000

FROM	TO	LITHOLOGIC LOG	FROM	TO	PLUGGING INTERVALS
0'	10'	Topsoil into clay			
10'	25'	HARD SANDSTONE			
25'	35'	MEDIUM SAND w/ SANDSTONE STRIPS			
35'	45'	SANDSTONE			
45'	55'	STICKY CLAY + LIME			
55'	62'	HARD SANDSTONE w/ LIMESTONE STRIPS			
62'	74'	CLAY AND SLIP CLAY STRIPS			
74'	83'	COARSE SAND AND SMALL GRAVEL			
83'	88'	STICKY CLAY			
88'	90'	COARSE SAND			
90'	94'	STICKY CLAY			
94'	102'	MEDIUM TO COARSE SAND			
102'	104'	STICKY CLAY			

7 CONTRACTOR'S OR LANDOWNER'S CERTIFICATION: This water well was (1) constructed (2) reconstructed, or (3) plugged under my jurisdiction and was completed on (mo/day/year) 06/25/05 and this record is true to the best of my knowledge and belief. Kansas Water Well Contractor's License No. 433 This Water Well Record was completed on (mo/day/yr) 03/15/06 under the business name of Chas Sargent Irrigation Co., Inc by (signature) Ray March