

CORRECTION(S) TO WATER WELL RECORD (WWC-5)
(to rectify lacking or incorrect information)

Location listed as:

Section-Township-Range: 25-2-2

Fraction (¼ ¼ ¼): NE

County: Republic

Location changed to:

25-2S-2W

NW NW NE

Other changes: Initial statements: _____

Changed to: _____

Comments: _____


verification method: Written & legal descriptions, well owner's address, position on plat map, and aerial photo on KGS website.

initials: DR date: 11/8/2005

1 LOCATION OF WATER WELL: Fraction Section Number Township Number Range Number
 County: Republic NE ¼ ¼ ¼ 25 2 2 E/W

Distance and direction from nearest town or city street address of well if located within city?
4 miles S of Munden, 2 1/2 E on Lincoln Rd.

2 WATER WELL OWNER: Robert Popelka
 RR #, St. Address, Box #: 2459 Lincoln Rd
 City, State, ZIP Code: Cuba, KS 66940
 Board of Agriculture, Division of Water Resources
 Application Number: _____

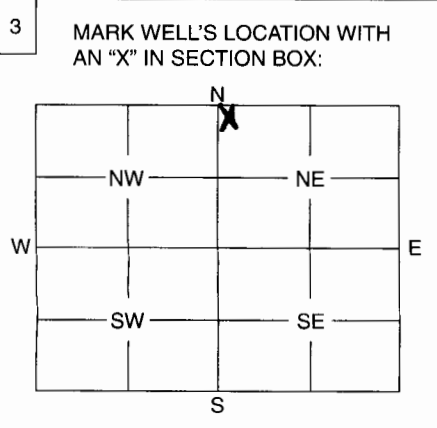

4 DEPTH OF WELL 26 ft.
 WELL'S STATIC WATER LEVEL 25 ft.
 WELL WAS USED AS:
 1 Domestic 5 Public Water Supply 9 Dewatering
 2 Irrigation 6 Oil Field Water Supply 10 Monitoring Well
 3 Feedlot 7 Domestic (Lawn & Garden) 11 Injection Well
 4 Industrial 8 Air Conditioning 12 Other

Was a chemical / bacteriological sample submitted to Department? Yes No
 If yes, mo/day/yr sample was submitted

Water Well Disinfected: Yes No

5 TYPE OF BLANK CASING USED:
 1 Steel 3 RMP (SR) 5 Wrought 7 Fiberglass 9 Other (Specify below)
 2 PVC 4 ABS 6 Asbestos-Cement 8 Concrete Tile

Blank casing diameter ... 5 in. Was casing pulled? Yes No If yes, how much 2'
 Casing height above or below land surface 108 in.

6 GROUT PLUG MATERIAL: 1 Neat cement 2 Cement grout 3 Bentonite 4 Other

Grout Plug Intervals: From 6 ft. to 9 ft., From ft. to ft., From to ft.

What is the nearest source of possible contamination:
 1 Septic tank 6 Seepage pit 11 Fuel storage 16 Other (specify below)
 2 Sewer lines 7 Pit privy 12 Fertilizer storage
 3 Watertight sewer lines 8 Sewage lagoon 13 Insecticide storage
 4 Lateral lines 9 Feedyard 14 Abandoned water well
 5 Cess pool 10 Livestock pens 15 Oil well/Gas well

Direction from well? How many feet?

FROM	TO	PLUGGING MATERIALS
0	6	In Pit, Left for hydrant use!
6	9	Bentonite
9	25	Subsoil
25	26	Gravel/Chlorine

7 CONTRACTOR'S OF LANDOWNER'S CERTIFICATION: This water well was plugged under my jurisdiction and was completed on (mo/day/year) and this record is true to the best of my knowledge and belief. Kansas Water Well Contractor's License No. 8719105 This Water Well Record was completed on (mo/day/year) under the business name of Robert Popelka by (signature) Robert Popelka

INSTRUCTIONS: Use typewriter or ball point pen. Please press firmly and print clearly. Please fill in blanks, underline or circle the correct answers. Send top three copies to Kansas Department of Health and Environment, Bureau of Water, Geology Section, 1000 SW Jackson St., Ste. 420, Topeka, Kansas 66612-1367. Telephone: 785/296-5522. Send one to Water Well Owner and retain one for your records.