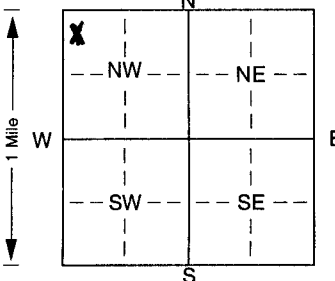


1 LOCATION OF WATER WELL: Fraction NW 1/4 NW 1/4 NW 1/4 Section Number 20 Township Number T 2 S R 21 Range Number 21 W
 County: NORTON

Distance and direction from nearest town or city street address of well if located within city?
From ALMENA, KS (WEST EDGE) 1.75 mile South

2 WATER WELL OWNER: BRAD HOPKINS
 RR#, St. Address, Box #: PO Box 246 Board of Agriculture, Division of Water Resources
 City, State, ZIP Code: ALMENA, KS 67647 Application Number:

3 LOCATE WELL'S LOCATION WITH AN "X" IN SECTION BOX:  DEPTH OF COMPLETED WELL: 74 ft. ELEVATION: ft.
 Depth(s) Groundwater Encountered 1. ft. 2. ft. 3. ft.
 WELL'S STATIC WATER LEVEL: 33 ft. below land surface measured on mo/day/yr 01/26/2006
 Pump test data: Well water was 39 ft. after 2 hours pumping 38 gpm
 Est. Yield 18 gpm: Well water was ft. after hours pumping gpm
 Bore Hole Diameter: 10 in. to 7.5 ft., and in. to ft.
 WELL WATER TO BE USED AS:
 1 Domestic 3 Feedlot 6 Oil field water supply 9 Dewatering 11 Injection well
 2 Irrigation 4 Industrial 7 Domestic (lawn & garden) 10 Monitoring well
 Was a chemical/bacteriological sample submitted to Department? Yes. No. X ; If yes, mo/day/yr sample was submitted
 Water Well Disinfected? Yes No

5 TYPE OF BLANK CASING USED:
 1 Steel 3 RMP (SR) 5 Wrought iron 8 Concrete tile CASING JOINTS: Glued. X Clamped.
 2 PVC 4 ABS 6 Asbestos-Cement 9 Other (specify below) Welded
 7 Fiberglass Threaded
 Blank casing diameter 4 1/2 in. to 7.4 ft., Dia in. to ft., Dia in. to ft.
 Casing height above land surface: 24 in., weight lbs./ft. Wall thickness or gauge No. 25-5490
 TYPE OF SCREEN OR PERFORATION MATERIAL:
 1 Steel 3 Stainless steel 5 Fiberglass 7 PVC 10 Asbestos-cement
 2 Brass 4 Galvanized steel 6 Concrete tile 8 RMP (SR) 11 Other (specify)
 9 ABS 12 None used (open hole)
 SCREEN OR PERFORATION OPENINGS ARE:
 1 Continuous slot 3 Mill slot 5 Gauzed wrapped 8 Saw cut 11 None (open hole)
 2 Louvered shutter 4 Key punched 6 Wire wrapped 9 Drilled holes
 7 Torch cut 10 Other (specify) ft.
 SCREEN-PERFORATED INTERVALS: From 6.4 ft. to 7.4 ft., From ft. to ft.
 From ft. to ft., From ft. to ft.
 GRAVEL PACK INTERVALS: From ft. to ft., From ft. to ft.
 From ft. to ft., From ft. to ft.

6 GROUT MATERIAL: 1 Neat cement 2 Cement grout 3 Bentonite 4 Other
 Grout Intervals: From 6 ft. to 27 ft., From ft. to ft., From ft. to ft.
 What is the nearest source of possible contamination:
 1 Septic tank 4 Lateral lines 7 Pit privy 10 Livestock pens 14 Abandoned water well
 2 Sewer lines 5 Cess pool 8 Sewage lagoon 11 Fuel storage 15 Oil well/Gas well
 3 Watertight sewer lines 6 Seepage pit 9 Feedyard 12 Fertilizer storage 16 Other (specify below)
 13 Insecticide storage NONE
 Direction from well? N/A How many feet?

FROM	TO	LITHOLOGIC LOG	FROM	TO	PLUGGING INTERVALS
0	20	Topsoil + clay			
20	40	CLAY w/ thin SILT SAND STRIPS			
40	50	CLAY w/ thin FINE SAND STRIPS			
50	60	FINE SAND w/ thin CLAY STRIPS			
60	68	MED. to COARSE SAND			
68	75	COARSE SAND to SMALL GRAVEL w/ FLINT			

7 CONTRACTOR'S OR LANDOWNER'S CERTIFICATION: This water well was (1) constructed, (2) reconstructed, or (3) plugged under my jurisdiction and was completed on (mo/day/year) 01/26/2006 and this record is true to the best of my knowledge and belief. Kansas Water Well Contractor's Licence No. 433 This Water Well Record was completed on (mo/day/yr) 03/23/2006 under the business name of Chas Sargent Irrigation Co., INC by (signature) Randy Moraska