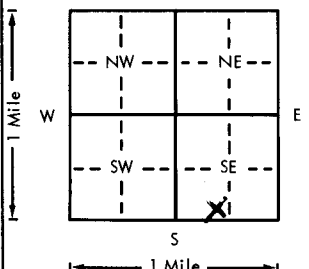


USE TYPEWRITER OR BALL
POINT PEN-PRESS FIRMLY,
PRINT CLEARLY.

WATER WELL RECORD
KSA 82a-1201-1215

Kansas Department of Health and
Environment-Division of Environment
(Water well Contractors)
Topeka, Kansas 66620

1. Location of well:		County: NORTON	Fraction: SE 1/4 SW 1/4 SE 1/4	Section number: 1	Township number: 2 S	Range number: 21 R	NE/W
2. Distance and direction from nearest town or city: → ALMENA → 4 mi. EAST, ON 383 HIWAY, 1/4 mi. South, 1/4 mi. WEST				3. Owner of well: DALE POND City, state, zip code: ALMENA, KANSAS 67622			
4. Locate with "X" in section below:		Sketch map:		6. Bore hole dia. 8 in. Completion date 9-16-77 Well depth 51 ft.			
				7. Cable tool <input checked="" type="checkbox"/> Rotary <input type="checkbox"/> Driven <input type="checkbox"/> Dug <input type="checkbox"/> Hollow rod <input type="checkbox"/> Jetted <input type="checkbox"/> Bored <input type="checkbox"/> Reverse rotary			
5. Type and color of material		From		To		8. Use: <input checked="" type="checkbox"/> Domestic <input type="checkbox"/> Public supply <input type="checkbox"/> Industry <input type="checkbox"/> Irrigation <input type="checkbox"/> Air conditioning <input checked="" type="checkbox"/> Stock <input type="checkbox"/> Lawn <input type="checkbox"/> Oil field water <input type="checkbox"/> Other	
BLACK TOP SOIL, AND BROWN CLAY		0'		31'		9. Casing: Material PVC Height: Above or below Threaded <input type="checkbox"/> Welded <input checked="" type="checkbox"/> Surface 12 in. RMP <input type="checkbox"/> PVC <input checked="" type="checkbox"/> Weight 2.72 lbs./ft. Dia. 5 in. to 50 ft. depth Wall thickness: inches or Dia. <input type="checkbox"/> in. to <input type="checkbox"/> ft. depth No. 258	
RED SAND AND GRAVEL		31'		46'		10. Screen: Manufacturer's name NEBRASKA PLASTICS Type Sch 40 PVC Dia. 5" Slot/gauze .30 Length 10' Set between 40 ft. and 50 ft. <input type="checkbox"/> ft. and <input type="checkbox"/> ft. Gravel pack? <input checked="" type="checkbox"/> Size range of material 3/8"	
BLACK SHALE		46'		51'		11. Static water level: 28 ft. below land surface Date 9/16/77	
BROCK 46'		46				12. Pumping level below land surfaces: 31 ft. after 1 hrs. pumping 25 g.p.m. <input type="checkbox"/> ft. after <input type="checkbox"/> hrs. pumping <input type="checkbox"/> g.p.m. Estimated maximum yield 50 g.p.m.	
18' sat thick						13. Water sample submitted: <input type="checkbox"/> Yes <input checked="" type="checkbox"/> No Date <input type="checkbox"/>	
in Alluvium						14. Well head completion: NO <input type="checkbox"/> Pinless adapter <input type="checkbox"/> inches above grade	
						15. Well grouted? YES With: <input type="checkbox"/> Neat cement <input type="checkbox"/> Bentonite <input checked="" type="checkbox"/> Concrete Depth: From 15 ft. to 5 ft.	
						16. Nearest source of possible contamination: ft. 60 Direction WEST Type SEPTIC Well disinfected upon completion? <input checked="" type="checkbox"/> Yes <input type="checkbox"/> No	
						17. Pump: <input checked="" type="checkbox"/> Not installed Manufacturer's name <input type="checkbox"/> Model number <input type="checkbox"/> HP <input type="checkbox"/> Volts <input type="checkbox"/> Length of drop pipe <input type="checkbox"/> ft. capacity <input type="checkbox"/> g.p.m. Type: <input type="checkbox"/> Submersible <input type="checkbox"/> Turbine <input type="checkbox"/> Jet <input type="checkbox"/> Reciprocating <input type="checkbox"/> Centrifugal <input type="checkbox"/> Other	
18. Elevation:		19. Remarks:		20. Water well contractor's certification:			
Topography: <input type="checkbox"/> Hill <input type="checkbox"/> Slope <input type="checkbox"/> Upland <input checked="" type="checkbox"/> Valley		2230 - very fine 2130 -46- 2050 430		This well was drilled under my jurisdiction and this report is true to the best of my knowledge and belief. MARUHN WELL DRILLING - 220 Business name OXFORD, NEBRASKA License No. 68967 Address Randy Maruhn Date 9/16/77 Signed Randy Maruhn Authorized representative			