


WATER WELL RECORD Form WWC-5 KSA 82a-1212

1 LOCATION OF WATER WELL: County: Norton Fraction: SE 1/4 NW 1/4 SE 1/4 Section Number: 8 Township Number: T 29 S Range Number: R 21 EW

Distance and direction from nearest town or city street address of well if located within city?

2 WATER WELL OWNER: Koch Agri Services RR#, St. Address, Box #: Almena, Kansas 67622 Board of Agriculture, Division of Water Resources City, State, ZIP Code: MW-3B Application Number:

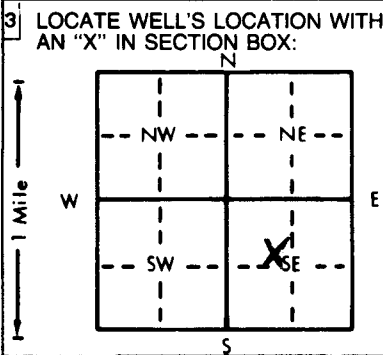

4 DEPTH OF COMPLETED WELL: 44.5 ft. ELEVATION: ... WELL'S STATIC WATER LEVEL: 23.03 ft. below land surface ... Pump test data: ... Est. Yield: ... Bore Hole Diameter: 6 in. to 44.5 ft. ... WELL WATER TO BE USED AS: 5 Public water supply, 8 Air conditioning, 11 Injection well, 12 Other (Specify below) ... Was a chemical/bacteriological sample submitted? No. X

5 TYPE OF BLANK CASING USED: 1 Steel, 2 PVC, 3 RMP (SR), 4 ABS, 5 Wrought iron, 6 Asbestos-Cement, 7 Fiberglass, 8 Concrete tile, 9 Other (specify below), 10 Asbestos-cement, 11 Other (specify), 12 None used (open hole) ... CASING JOINTS: Glued, Clamped, Welded, Threaded. X ... Blank casing diameter: 2 in. to 34.5 ft., Dia. ... Casing height above land surface: 2.87 in., weight 71.6 lbs./ft. Wall thickness or gauge No. 154 ... TYPE OF SCREEN OR PERFORATION MATERIAL: 1 Steel, 2 Brass, 3 Stainless steel, 4 Galvanized steel, 5 Fiberglass, 6 Concrete tile, 7 PVC, 8 RMP (SR), 9 ABS, 10 Asbestos-cement, 11 Other (specify), 12 None used (open hole) ... SCREEN OR PERFORATION OPENINGS ARE: 1 Continuous slot, 2 Louvered shutter, 3 Mill slot, 4 Key punched, 5 Gauzed wrapped, 6 Wire wrapped, 7 Torch cut, 8 Saw cut, 9 Drilled holes, 10 Other (specify), 11 None (open hole) ... SCREEN-PERFORATED INTERVALS: From 34.5 ft. to 44.5 ft. ... GRAVEL PACK INTERVALS: From 32 ft. to 44.5 ft.

6 GROUT MATERIAL: 1 Neat cement, 2 Cement grout, 3 Bentonite, 4 Other ... Grout Intervals: From 0 ft. to 30 ft., From 30 ft. to 32 ft. ... What is the nearest source of possible contamination: 1 Septic tank, 2 Sewer lines, 3 Watertight sewer lines, 4 Lateral lines, 5 Cess pool, 6 Seepage pit, 7 Pit privy, 8 Sewage lagoon, 9 Feedyard, 10 Livestock pens, 11 Fuel storage, 12 Fertilizer storage, 13 Insecticide storage, 14 Abandoned water well, 15 Oil well/Gas well, 16 Other (specify below)

Direction from well? How many feet? LITHOLOGIC LOG PLUGGING INTERVALS

FROM	TO	LITHOLOGIC LOG	FROM	TO	PLUGGING INTERVALS
0	1.5	Silt w/Clay & Gravel			
1.5	4	Silt w/some Clay			
4	7.5	Bown to Grey Silt w/Some Clay			
7.5	19	Lt. Brown Silt w/some Clay			
19	20.5	Silt w/Clay & Very Fine Sand			
20.5	24	Sand w/Some Silt & Clay			
24	32	Sand w/some Silt & Little Clay			
32	35.5	Sand, Very Fine w/Some Clay			
35.5	36.25	Clay w/a little Silt			
26.25	44.5	Sand, Very Fine w/Some Silt			

7 CONTRACTOR'S OR LANDOWNER'S CERTIFICATION: This water well was (1) constructed, (2) reconstructed, or (3) plugged under my jurisdiction and was completed on (mo/day/year) 3-2-94 and this record is true to the best of my knowledge and belief. Kansas Water Well Contractor's License No. 554 This Water Well Record was completed on (mo/day/yr) 5-9-94 under the business name of Woofter Pump & Well, Inc. by (signature) Gary C. Woofter