USE TYPEWRITER OR BALL POINT PEN-PRESS FIRMLY, PRINT CLEARLY.

almena

T	R	EW	sec	1/4	1/4	1/4	No.

WATER WELL RECORD
KSA 82a-1201-1215

Kansas State Dept. Of Health
(Water Well Contractors)
Forbes-Bldg. 740
Topeka, Kansas 66620

1 Location of well:	County	Township name	Fraction	Section number	Town number	Range number
	Norton	ALMENA	~~S W 1/4~~ of NE 1/4	~~7~~ 10	~~10~~ 2	21

Distance and direction from nearest town or city: 1½E of Almena
Street address of well location if in city: ½ south

3 Owner of well: Norman L. Nelson & Wife
Stanley Nelson & Wife
Address: Long Island Kansas

Locate with "X" in section below:

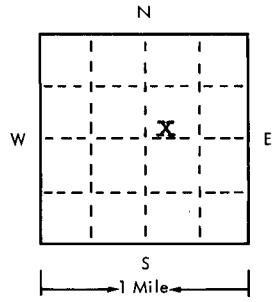

Sketch map:

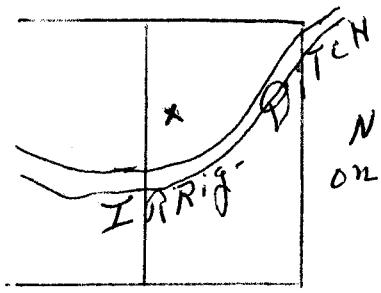

No-Building on-SEC.

4 Well depth: 80 ft. Date of completion ____
Well diameter 16 in.

5 ☐ Cable tool ☐ Rotary ☐ Driven ☐ Dug
☐ Hollow rod ☐ Jetted ☐ Bored ☒ Reverse rotary

6 Use: ☐ Domestic ☐ Public supply ☐ Industry
☒ Irrigation ☐ Air conditioning ☐ Commercial
☐ Test well ☐ ____

7 Casing: Material steel Height: above/below
Threaded ☐ Welded ☒ Surface 18 in.
Diam. 16 Weight 24 lbs./ft.
0 in. to 44 ft. depth Drive shoe? ☐ Yes ☑ No
~~__~~ in. to ~~80~~ ft. depth

8 Screen:
Manufacturer Hastings
Type steel Dia. 16
Slot/gauze 1/8 Length 21 ½
Set between 44 ft. and 80 ft.
Fittings:
Gravel pack ☒ Yes ☐ No Size range of material ~~1/4~~ 3/8

2 Type and color of material	From	To
Top soil	0	5
Br & Blk. clay	5	15
Clay	15	49
Clay & sand	49	50
Sand & rocks	50	69
Clay & Blue Clay	69	71
Corase sand	71	80
(use a second sheet if needed)		

9 Static water level:
28 ft. below land surface Date 12-31-74

10 Pumping level below land surfaces:
70 ft. after ____ hrs. pumping ____ g.p.m.
____ ft. after ____ hrs. pumping ____ g.p.m.
Estimated maximum yield 600 g.p.m.

11 Water sample submitted:
☐ Yes ☑ No Date ____

12 Well head completion:
☐ Pitless adapter 18 Inches above grade

13 Well grouted? ☒ Yes ☐ No
☒ Neat cement ☐ Bentonite ☐ ____
Depth: From 0 ft. to 10 ft.

14 Nearest source of possible contamination: NONE
ft. ____ Direction ____ Type ____
Well disinfected upon completion? ☐ Yes ☐ No

15 Pump: ☐ Not installed
Manufacturer's name Peerless Pump
Model number ____ HP ____ Volts ____
Length of drop pipe 70 ft. capacity 650 g.m.p.
Type:
☐ Submersible ☑ Turbine
☐ Jet ☐ Reciprocating
☐ Certrifugal ☐ Other

16 Remarks: elevation
Customer installed Concrete at surface & knows the regulations.
7144

Topography:
☐ Hill
☑ Slope
☐ Upland
☐ Valley

17 Water well contractor's certification:
This well was drilled under my jurisdiction and this report is true to the best of my knowledge and belief.
Peerless Machine & MFG. Co.
Business name License No. 215
Address Box 564 Kearney, Nebr
Signed [signature] Date 1-20-77
Authorized representative

Forward the white, blue and pink copies to the Kansas State Dept. Of Health.

Form WWC-5

S 14 W 10 SE