


1 LOCATION OF WATER WELL: County: NORTON Fraction: SE 1/4 SE 1/4 NE 1/4 Section Number: 26 Township Number: T 2 S Range Number: R 22 E/W

Distance and direction from nearest town or city street address of well if located within city?
SW CORNER OF HWY 383 AND COUNTY ROAD IN CALVERT, KS

2 WATER WELL OWNER: CALVERT STATION
 RR#, St. Address, Box #: 6209 N. Hwy 61 Board of Agriculture, Division of Water Resources
 City, State, ZIP Code: ALMENA, KS Application Number: MW-11

3 LOCATE WELL'S LOCATION WITH AN "X" IN SECTION BOX:

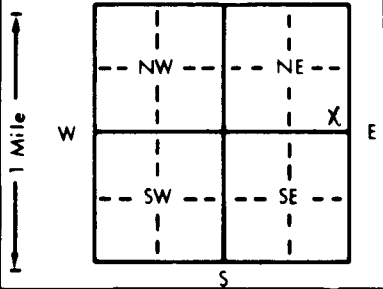

4 DEPTH OF COMPLETED WELL: 49.5 ft. ELEVATION: _____
 Depth(s) Groundwater Encountered 1. 40 ft. 2. _____ ft. 3. _____ ft.
 WELL'S STATIC WATER LEVEL: 39.83 ft. below land surface measured on mo/day/yr 2/22/96
 Pump test data: Well water was _____ ft. after _____ hours pumping _____ gpm
 Est. Yield _____ gpm: Well water was _____ ft. after _____ hours pumping _____ gpm
 Bore Hole Diameter: 8.25 in. to 50 ft., and _____ in. to _____ ft.
 WELL WATER TO BE USED AS: 5 Public water supply 8 Air conditioning 11 Injection well
 1 Domestic 3 Feedlot 6 Oil field water supply 9 Dewatering 12 Other (Specify below)
 2 Irrigation 4 Industrial 7 Lawn and garden only 10 Monitoring well
 Was a chemical/bacteriological sample submitted to Department? Yes No; If yes, mo/day/yr sample was submitted _____
 Water Well Disinfected? Yes No

5 TYPE OF BLANK CASING USED: 1 Steel 3 RMP (SR) 5 Wrought iron 8 Concrete tile CASING JOINTS: Glued _____ Clamped _____
2 PVC 4 ABS 7 Fiberglass _____ Threaded _____
 Blank casing diameter: 2 in. to 29.5 ft., Dia _____ in. to _____ ft., Dia _____ in. to _____ ft.
 Casing height above land surface: _____ in., weight _____ lbs./ft. Wall thickness or gauge No. _____

TYPE OF SCREEN OR PERFORATION MATERIAL: 7 PVC 10 Asbestos-cement
 1 Steel 3 Stainless steel 5 Fiberglass 8 RMP (SR) 11 Other (specify) _____
 2 Brass 4 Galvanized steel 6 Concrete tile 9 ABS 12 None used (open hole)

SCREEN OR PERFORATION OPENINGS ARE: 1 Continuous slot 3 Mill slot 5 Gauzed wrapped 8 Saw cut 11 None (open hole)
 2 Louvered shutter 4 Key punched 6 Wire wrapped 9 Drilled holes
 7 Torch cut 10 Other (specify) _____

SCREEN-PERFORATED INTERVALS: From 49.5 ft. to 29.5 ft., From _____ ft. to _____ ft.
 From _____ ft. to _____ ft., From _____ ft. to _____ ft.

GRAVEL PACK INTERVALS: From 50 ft. to 28.5 ft., From _____ ft. to _____ ft.
 From _____ ft. to _____ ft., From _____ ft. to _____ ft.

6 GROUT MATERIAL: 1 Neat cement 2 Cement grout 3 Bentonite 4 Other CONCRETE
 Grout Intervals: From 28.5 ft. to 26.5 ft., From 26.5 ft. to 1 ft., From 1 ft. to 0 ft.

What is the nearest source of possible contamination:
 1 Septic tank 4 Lateral lines 7 Pit privy 10 Livestock pens 14 Abandoned water well
 2 Sewer lines 5 Cess pool 8 Sewage lagoon 11 Fuel storage 15 Oil well/Gas well
 3 Watertight sewer lines 6 Seepage pit 9 Feedyard 12 Fertilizer storage 16 Other (specify below)
 13 Insecticide storage

Direction from well? ESE How many feet? 160'

FROM	TO	LITHOLOGIC LOG	FROM	TO	PLUGGING INTERVALS
0'	7'	BROWN SILT, CLAY, SOME PLASTIC DEBRIS			
7'	22'	BROWN CLAYEY SILT, CONCRETE DEBRIS, CARPET PIECES, WIRE			
22'	42'	BROWN CLAYEY, SILT, NO DEBRIS			
42'	50'	BROWN CLAYEY, SILT, SOME FINE GRAIN SAND, AT 48'			

7 CONTRACTOR'S OR LANDOWNER'S CERTIFICATION: This water well was 1 constructed, (2) reconstructed, or (3) plugged under my jurisdiction and was completed on (mo/day/year) 2/19/96 and this record is true to the best of my knowledge and belief. Kansas Water Well Contractor's License No. 589 This Water Well Record was completed on (mo/day/yr) 2/28/96 under the business name of KANSAS CITY TESTING LAB by (signature) [Signature]