


1 LOCATION OF WATER WELL: Fraction NW 1/4 NE 1/4 NW 1/4 Section Number 18 Township Number T 2 S Range Number R 22 EW
 County: Norton

Distance and direction from nearest town or city street address of well if located within city?
From junction 36+283 Approx 3 1/4 mi. North + 2 mi. East of Norton

2 WATER WELL OWNER: Darrell Ambroiser
 RR#, St. Address, Box # : _____ Board of Agriculture, Division of Water Resources
 City, State, ZIP Code : Almena, KS 67622 Application Number: _____

3 LOCATE WELL'S LOCATION WITH AN "X" IN SECTION BOX:

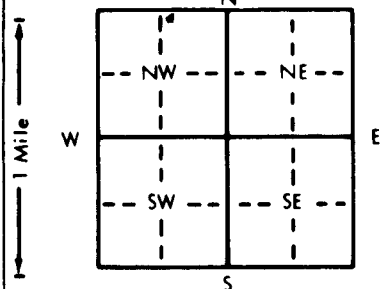

4 DEPTH OF COMPLETED WELL: 58 ft. ELEVATION: _____
 Depth(s) Groundwater Encountered 1. _____ ft. 2. _____ ft. 3. _____ ft.
 WELL'S STATIC WATER LEVEL 41 ft. below land surface measured on mo/day/yr

Pump test data: Well water was _____ ft. after _____ hours pumping _____ gpm
 Est. Yield _____ gpm; Well water was _____ ft. after _____ hours pumping _____ gpm
 Bore Hole Diameter 9 in. to 20 ft., and 8 in. to 58 ft.
 WELL WATER TO BE USED AS: 5 Public water supply 8 Air conditioning 11 Injection well
 1 Domestic 3 Feedlot 6 Oil field water supply 9 Dewatering 12 Other (Specify below)
 2 Irrigation 4 Industrial 7 Lawn and garden only 10 Monitoring well
 Was a chemical/bacteriological sample submitted to Department? Yes _____ No ; If yes, mo/day/yr sample was submitted
 Water Well Disinfected? Yes No

5 TYPE OF BLANK CASING USED: 5 Wrought iron 8 Concrete tile CASING JOINTS: Glued Clamped _____
 1 Steel 3 RMP (SR) 6 Asbestos-Cement 9 Other (specify below) Welded _____
 2 PVC 4 ABS 7 Fiberglass _____ Threaded _____
 Blank casing diameter 5 in. to 38 ft., Dia _____ in. to _____ ft., Dia _____ in. to _____ ft.
 Casing height above land surface 12 in., weight _____ lbs./ft. Wall thickness or gauge No. SDR 21

TYPE OF SCREEN OR PERFORATION MATERIAL: 7 PVC 10 Asbestos-cement
 1 Steel 3 Stainless steel 5 Fiberglass 8 RMP (SR) 11 Other (specify) _____
 2 Brass 4 Galvanized steel 6 Concrete tile 9 ABS 12 None used (open hole)

SCREEN OR PERFORATION OPENINGS ARE: 5 Gauzed wrapped 8 Saw cut 11 None (open hole)
 1 Continuous slot 3 Mill slot 6 Wire wrapped 9 Drilled holes
 2 Louvered shutter 4 Key punched 7 Torch cut 10 Other (specify) _____

SCREEN-PERFORATED INTERVALS: From 38 ft. to 58 ft., From _____ ft. to _____ ft.
 From _____ ft. to _____ ft., From _____ ft. to _____ ft.
 GRAVEL PACK INTERVALS: From 25 ft. to 58 ft., From _____ ft. to _____ ft.
 From _____ ft. to _____ ft., From _____ ft. to _____ ft.

6 GROUT MATERIAL: 1 Neat cement 2 Cement grout 3 Bentonite 4 Other _____
 Grout Intervals: From 5 ft. to 25 ft., From _____ ft. to _____ ft., From _____ ft. to _____ ft.

What is the nearest source of possible contamination:
 1 Septic tank 4 Lateral lines 7 Pit privy 10 Livestock pens 14 Abandoned water well
 2 Sewer lines 5 Cess pool 8 Sewage lagoon 11 Fuel storage 15 Oil well/Gas well
 3 Watertight sewer lines 6 Seepage pit 9 Feedyard 12 Fertilizer storage 16 Other (specify below)
 13 Insecticide storage
 Direction from well? S How many feet? 250'

FROM	TO	LITHOLOGIC LOG	FROM	TO	PLUGGING INTERVALS
0	29	Top Soil & Clay			
29	48	Clay with traces sandstone & fine sand			
48	52	Cleaner sand			
52	55	Clay with sand thru			
55	58	Sandy clay			
58		Ochre			

7 CONTRACTOR'S OR LANDOWNER'S CERTIFICATION: This water well was (1) constructed, (2) reconstructed, or (3) plugged under my jurisdiction and was completed on (mo/day/year) 9-20-93 and this record is true to the best of my knowledge and belief. Kansas Water Well Contractor's License No. 428 This Water Well Record was completed on (mo/day/yr) 11-15-93 under the business name of STALDER DRILLING by (signature) Jerry L. Stalder