USE TYPEWRITER OR BALL POINT PEN-PRESS FIRMLY, PRINT CLEARLY.

Valvert

CCL

WATER WELL RECORD
KSA 82a-1201-1215

Kansas Department of Health and Environment-Division of Environment
(Water well Contractors)
Topeka, Kansas 66620

1. Location of well:	County	Fraction	Section number	Township number	Range number
	Norton	SE 1/4 SW 1/4 SW 1/4	31	T 2 S	R 22 W E/W

2. Distance and direction from nearest town or city: 2 Mi East of Norton Kansas
Street address of well location if in city:

3. Owner of well: Dennis Gilhousen
R.R. or street:
City, state, zip code: Norton Kansas

4. Locate with "X" in section below:

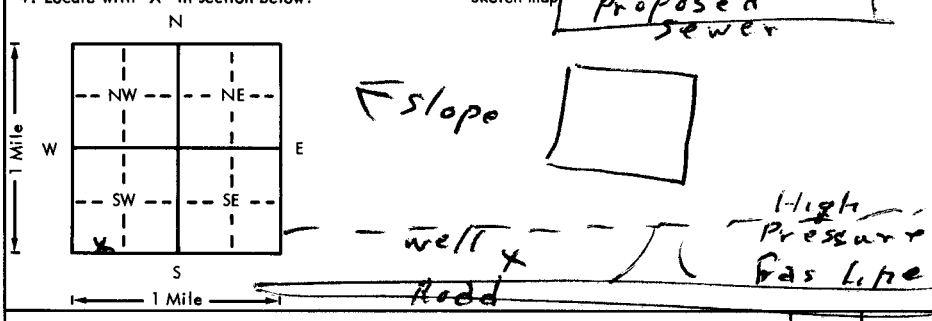

6. Bore hole dia. 9 in. Completion date 5/20/76
Well depth 70 ft.

7. __ Cable tool X Rotary __ Driven __ Dug
__ Hollow rod __ Jetted __ Bored __ Reverse rotary

8. Use: X Domestic __ Public supply __ Industry
__ Irrigation __ Air conditioning __ Stock
__ Lawn __ Oil field water __ Other

9. Casing: Material PVC Height: Above or below
Threaded ___ Welded ___ Surface 12 in.
RMP X PVC ___ Weight 280 lbs./ft.
Dia. 5 in. to 55 ft. depth Wall Thickness: inches or
Dia. ___ in. to ___ ft. depth gage No. 250

5. Type and color of material	From	To
Clay	0	31
Sandy clay	31	51
Sand (medium coarse)	51	63
Brown Shale	63	70
BROCK 63'		
35		
28' sat th 2249		
2171		
in Og		

(Use a second sheet if needed)

10. Screen: Manufacturer's name Modernpipe Inc.
Type PVC Dia. 5"
Slot/gauze Slot Length 15'
Set between 55 ft. and 70 ft.
ft. and ft.
Gravel pack? Yes Size range of material 1/4 x 1/8

11. Static water level: mo./day/yr.
35 ft. below land surface Date 5/19/76

12. Pumping level below land surfaces:
ft. after hrs. pumping g.p.m.
ft. after hrs. pumping g.p.m.
Estimated maximum yield 25 g.p.m.

13. Water sample submitted: mo./day/yr.
__ Yes X No Date

14. Well head completion:
X Pitless adapter 12 Inches above grade

15. Well grouted? Yes
With: __ Neat cement __ Bentonite X Concrete
Depth: From 4 ft. to 16 ft.

16. Nearest source of possible contamination: None
ft. Direction Type
Well disinfected upon completion? X Yes __ No

17. Pump: __ Not installed
Manufacturer's name Aermotor
Model number SB12-50 HP 1/2 Vol. 270
Length of drop pipe 59 ft. capacity 12 g.p.m.
Type:
X Submersible __ Turbine
__ Jet __ Reciprocating
__ Centrifugal __ Other

T 2 S
R 22 W
Sec 31
SE 1/4 SW 1/4 SW 1/4

18. Elevation:
Topography:
__ Hill
__ Slope
__ Upland
__ Valley

19. Remarks:
New home under Construction
240

20. Water well contractor's certification:
This well was drilled under my jurisdiction and this report is true to the best of my knowledge and belief.
John R. Fawcett & Son 167
Business name License No.
Address Norton Kansas
Signed John R. Fawcett Date 5/20/76
Authorized representative

Forward the white, blue and pink copies to the Department of Health and Environment

Form WWC-5