

Corrected

MW 2

WATER WELL PLUGGING RECORD Form WWC-5P KSA 82a-1212 ID NO.


1 LOCATION OF WATER WELL: County: Norton Fraction SE 1/4 se 1/4 se 1/4 ne 1/4 Section Number 26 Township Number T 2 S Range Number 22 E W

Street/Rural Address of Well Location; if unknown, distance & direction from nearest town or intersection: If at owner's address, check here Rural Route 1 Calvert, KS 67622

Global Positioning Systems (GPS) information: Latitude: 39.850596 Longitude: -99.758751 Elevation: 2198.89 Horizontal Datum: WGS84, NAD83, NAD27 Collection Method:

2 WATER WELL OWNER: Devall, Millard RR#, St. Address, Box #: Rural Route 1 City, State ZIP Code: Alma, KS 67722

GPS unit (Make/Model): Digital Map/Photo, Topographic Map, Land Survey Est. Accuracy: 3-5 m

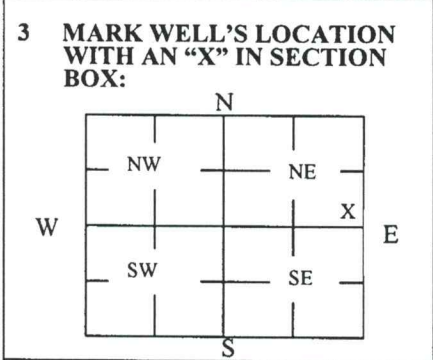

3 MARK WELL'S LOCATION WITH AN 'X' IN SECTION BOX: 4 DEPTH OF WELL 47.40 ft. WELL'S STATIC WATER LEVEL 37.72 ft. WELL WAS USED AS: Domestic, Irrigation, Feedlot, Industrial, Public Water Supply, Oil Field Water Supply, Domestic (Lawn & Garden), Air Conditioning, Dewatering, Monitoring, Injection Well, Other MW-2. Was a chemical/bacteriological sample submitted to Department? Yes No

5 TYPE OF BLANK CASING USED: Steel, PVC, RMP (SR), ABS, Wrought, Asbestos-Cement, Fiberglass, Concrete Tile, Other. Blank casing diameter 2 in. Was casing pulled? Yes No. Casing height above or below land surface -36 in.

6 GROUT PLUG MATERIAL: Neat cement, Cement grout, Bentonite, Other. Grout Plug Intervals: From 3 ft. to 47.40 ft., From ft. to ft., From ft. to ft.

What is the nearest source of possible contamination: Septic tank, Sewer lines, Watertight sewer lines, Lateral lines, Cess pool, Seepage pit, Pit privy, Sewage lagoon, Feedyard, Livestock pens, Fuel storage, Fertilizer storage, Insecticide storage, Abandoned water well, Oil well/Gas well, Other (specify below). Direction from well? How many feet?

Table with columns: FROM, TO, PLUGGING MATERIALS. Row 1: 0, 3, Native Soil. Row 2: 3, 47.40, Hi-solids/bentonite chips.

7 CONTRACTOR'S OR LANDOWNER'S CERTIFICATION: This water well was plugged under my jurisdiction and was completed on (mo/day/year) 06/13/2022 and this record is true to the best of my knowledge and belief. Kansas Water Well Contractor's License No. 929. This Water Well Record was completed on (mo/day/year) 06/16/2022 under the business name of Southwest Environmental Engineering LLC by (signature) [Signature]

Send one white copy to Kansas Department of Health & Environment, Geology Section, 1000 SW Jackson Street, Ste. 420, Topeka, KS 66612-1367. Send one copy to WATER WELL OWNER and retain one for your records. Visit us at http://www.kdheks.gov/waterwell/index.html Telephone 785-296-5524.