WATER WELL RECORD Form WWC-5 KSA 82a-1212 MW2

1 LOCATION OF WATER WELL: County: NORTON | Fraction: SW ¼ NW ¼ NE ¼ | Section Number: 34 | Township Number: T 2 S | Range Number: R 23 E(W)

Distance and direction from nearest town or city street address of well if located within city?
302' N.N.E. OF INTERSECTION OF HIGHWAY 36/383 AND BROWN AVE., NORTON, KS

2 WATER WELL OWNER: VERN JACOBS
RR#, St. Address, Box # : 607 WEST HOLME
City, State, ZIP Code : NORTON, KS 67654

Board of Agriculture, Division of Water Resources
Application Number:

3 LOCATE WELL'S LOCATION WITH AN "X" IN SECTION BOX:

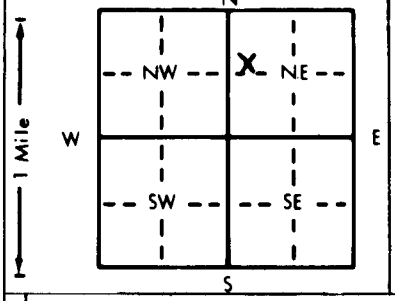

4 DEPTH OF COMPLETED WELL 77.89 ft. ELEVATION: 2344.32' (RIM)
Depth(s) Groundwater Encountered 1. 72 ft. 2. ft. 3. ft.
WELL'S STATIC WATER LEVEL 72.11 ft. below land surface measured on mo/day/yr 8/18/95
Pump test data: Well water was ft. after hours pumping gpm
Est. Yield gpm: Well water was ft. after hours pumping gpm
Bore Hole Diameter 8.5 in. to 78.5 ft., and in. to ft.
WELL WATER TO BE USED AS: 1 Domestic 2 Irrigation 3 Feedlot 4 Industrial 5 Public water supply 6 Oil field water supply 7 Lawn and garden only 8 Air conditioning 9 Dewatering (10 Monitoring well) 11 Injection well 12 Other (Specify below)
Was a chemical/bacteriological sample submitted to Department? Yes No X; If yes, mo/day/yr sample was submitted
Water Well Disinfected? Yes No X

5 TYPE OF BLANK CASING USED: 1 Steel (2 PVC) 3 RMP (SR) 4 ABS 5 Wrought iron 6 Asbestos-Cement 7 Fiberglass 8 Concrete tile 9 Other (specify below)
CASING JOINTS: Glued Clamped Welded (Threaded) 2 T.P.I.
Blank casing diameter 2.067"/2.375" (ID)(OD) in. to 57.7 ft., Dia in. to ft., Dia in. to ft.
Casing height above land surface -2.4 in., weight .695 lbs./ft. Wall thickness or gauge No. .154
TYPE OF SCREEN OR PERFORATION MATERIAL: 1 Steel 2 Brass 3 Stainless steel 4 Galvanized steel 5 Fiberglass 6 Concrete tile (7 PVC) 8 RMP (SR) 9 ABS 10 Asbestos-cement 11 Other (specify) 12 None used (open hole)
SCREEN OR PERFORATION OPENINGS ARE: 1 Continuous slot (3 Mill slot) 2 Louvered shutter 4 Key punched 5 Gauzed wrapped 6 Wire wrapped 7 Torch cut 8 Saw cut 9 Drilled holes 10 Other (specify) 11 None (open hole)
SCREEN-PERFORATED INTERVALS: From 57.7 ft. to 77.7 ft., From ft. to ft.
From ft. to ft., From ft. to ft.
GRAVEL PACK INTERVALS: From 44 ft. to 78.5 ft., From ft. to ft.
From ft. to ft., From ft. to ft.

6 GROUT MATERIAL: 1 Neat cement 2 Cement grout (3 Bentonite) 4 Other
Grout Intervals: From 1 ft. to 44 ft., From ft. to ft., From ft. to ft.
What is the nearest source of possible contamination:
1 Septic tank 2 Sewer lines 3 Watertight sewer lines 4 Lateral lines 5 Cess pool 6 Seepage pit 7 Pit privy 8 Sewage lagoon 9 Feedyard 10 Livestock pens (11 Fuel storage (former)) 12 Fertilizer storage 13 Insecticide storage 14 Abandoned water well 15 Oil well/Gas well 16 Other (specify below) product line
Direction from well? SOUTH SOUTH EAST How many feet? 105'

FROM	TO	LITHOLOGIC LOG	FROM	TO	PLUGGING INTERVALS
0'	18'	LT. BROWN CLAYEY SILT			
18'	31'	BROWN TO V. LT. BROWN SILTY CLAY			
31'	46'	V. LT. BROWN CLAYEY SILT TO SILT			
46'	55'	LT. BROWN SANDY SILT TO SILTY SAND ~~TO SAND~~			
55'	70'	V. LT. BROWN SILTY TO CLEAN SAND			
70'	78.5'	LT. YELLOW WEATHERED LIMESTONE AND GRAVEL			
78.5'		LT. BROWNISH YELLOW LIMESTONE			

7 CONTRACTOR'S OR LANDOWNER'S CERTIFICATION: This water well was (1) constructed, (2) reconstructed, or (3) plugged under my jurisdiction and was completed on (mo/day/year) 8/12/95 and this record is true to the best of my knowledge and belief. Kansas Water Well Contractor's License No. 594 This Water Well Record was completed on (mo/day/yr) 9/25/95 under the business name of by (signature)

INSTRUCTIONS: Use typewriter or ball point pen. *PLEASE PRESS FIRMLY* and *PRINT* clearly. Please fill in blanks, underline or circle the correct answers. Send top three copies to Kansas Department of Health and Environment, Bureau of Water, Topeka, Kansas 66620-0001. Telephone: 913-296-5545. Send one to WATER WELL OWNER and retain one for your records.