WATER WELL RECORD Form WWC-5 KSA 82a-1212

MW3

1 LOCATION OF WATER WELL: County: NORTON | Fraction: SW ¼ NW ¼ NE ¼ | Section Number: 34 | Township Number: T 3S 2 S | Range Number: R 23 E (W)

Distance and direction from nearest town or city street address of well if located within city?
302' NORTHEAST OF INTERSECTION OF HIGHWAY 36/383 AND BROWN AVE., NORTON, KS

2 WATER WELL OWNER: VERN JACOBS
RR#, St. Address, Box # : 607 WEST HOLME
City, State, ZIP Code : NORTON, KS 67654

Board of Agriculture, Division of Water Resources
Application Number:

3 LOCATE WELL'S LOCATION WITH AN "X" IN SECTION BOX:

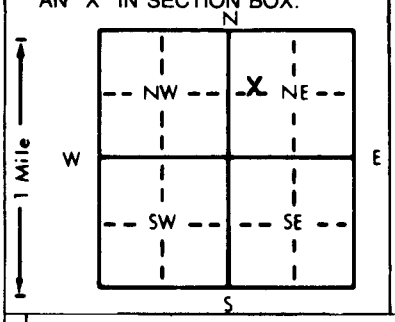

4 DEPTH OF COMPLETED WELL: 73.45 ft. ELEVATION: ~~2348~~ 2343.28 (RIM)
Depth(s) Groundwater Encountered 1. 71.2 ft. 2. ft. 3. ft.
WELL'S STATIC WATER LEVEL 71.3 ft. below land surface measured on mo/day/yr 8/18/95
Pump test data: Well water was ft. after hours pumping gpm
Est. Yield gpm: Well water was ft. after hours pumping gpm
Bore Hole Diameter 8.5 in. to 73.5 ft., and in. to ft.
WELL WATER TO BE USED AS: 5 Public water supply 8 Air conditioning 11 Injection well
1 Domestic 3 Feedlot 6 Oil field water supply 9 Dewatering 12 Other (Specify below)
2 Irrigation 4 Industrial 7 Lawn and garden only (10 Monitoring well)
Was a chemical/bacteriological sample submitted to Department? Yes No X; If yes, mo/day/yr sample was submitted
Water Well Disinfected? Yes No X

5 TYPE OF BLANK CASING USED: 5 Wrought iron 8 Concrete tile CASING JOINTS: Glued Clamped
1 Steel 3 RMP (SR) 6 Asbestos-Cement 9 Other (specify below) Welded
(2 PVC) 4 ABS 7 Fiberglass (Threaded) 2 TPI
Blank casing diameter 2.067"/2.375" ID/OD in. to 53.25 ft., Dia in. to ft., Dia in. to ft.
Casing height above land surface -3.0 in., weight .695 lbs./ft. Wall thickness or gauge No. .154
TYPE OF SCREEN OR PERFORATION MATERIAL: (7 PVC) 10 Asbestos-cement
1 Steel 3 Stainless steel 5 Fiberglass 8 RMP (SR) 11 Other (specify)
2 Brass 4 Galvanized steel 6 Concrete tile 9 ABS 12 None used (open hole)
SCREEN OR PERFORATION OPENINGS ARE: 5 Gauzed wrapped 8 Saw cut 11 None (open hole)
1 Continuous slot (3 Mill slot) 6 Wire wrapped 9 Drilled holes
2 Louvered shutter 4 Key punched 7 Torch cut 10 Other (specify)
SCREEN-PERFORATED INTERVALS: From 53.25 ft. to 73.25 ft., From ft. to ft.
From ft. to X ft., From ft. to ft.
GRAVEL PACK INTERVALS: From 56 ft. to 73.5 ft., From ft. to ft.
From ft. to ft., From ft. to ft.

6 GROUT MATERIAL: 1 Neat cement 2 Cement grout (3 Bentonite) 4 Other
Grout Intervals: From 1 ft. to 56 ft., From ft. to ft., From ft. to ft.
What is the nearest source of possible contamination: 10 Livestock pens 14 Abandoned water well
1 Septic tank 4 Lateral lines 7 Pit privy (11 Fuel storage (former product line)) 15 Oil well/Gas well
2 Sewer lines 5 Cess pool 8 Sewage lagoon 12 Fertilizer storage 16 Other (specify below)
3 Watertight sewer lines 6 Seepage pit 9 Feedyard 13 Insecticide storage
Direction from well? SOUTH WEST How many feet? 48'

FROM	TO	LITHOLOGIC LOG	FROM	TO	PLUGGING INTERVALS
.3'	11.5'	LT. GRAY BROWN, (FILL) SAND			
11.5'	28'	LT. BROWN, CLAYEY SILT			
28'	31'	V. LT. BROWN, SILTY CLAY			
31'	41'	V. LT. BROWN, CLAYEY SILT			
41'	48'	V. LT BROWN, SANDY CLAYEY SILT			
48'	56'	V. LT. BROWN CLAYEY SANDY SILT			
56'	72'	V. LT. BROWN TO LT. BROWN SAND			
		TO SILTY SAND WITH DEPTH			
72'	73.5'	LT. BROWNISH WEATHERED LIMESTONE			
		AND CLAY			
73.5'		LT. BROWNISH YELLOW LIMESTONE			

7 CONTRACTOR'S OR LANDOWNER'S CERTIFICATION: This water well was (1) constructed (2) reconstructed, or (3) plugged under my jurisdiction and was completed on (mo/day/year) 8/12/95 and this record is true to the best of my knowledge and belief. Kansas Water Well Contractor's License No. 594 This Water Well Record was completed on (mo/day/yr) 9/25/95
under the business name of by (signature)

INSTRUCTIONS: Use typewriter or ball point pen. *PLEASE PRESS FIRMLY* and *PRINT* clearly. Please fill in blanks, underline or circle the correct answers. Send top three copies to Kansas Department of Health and Environment, Bureau of Water, Topeka, Kansas 66620-0001. Telephone: 913-296-5545. Send one to WATER WELL OWNER and retain one for your records.