

1 LOCATION OF WATER WELL: County: <b>Norton</b>	Fraction <b>SE ¼ SE ¼ SE ¼</b>	Section Number <b>34</b>	Township Number <b>T 2 S</b>	Range Number <b>R 23 E/W</b>
--	-----------------------------------	-----------------------------	---------------------------------	---------------------------------

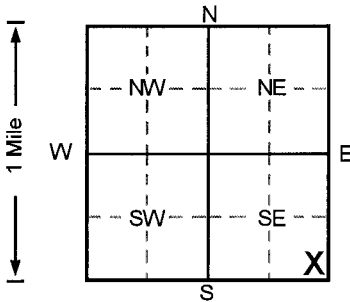
Distance and direction from nearest town or city street address of well if located within city?

**115 W. Main - Norton, Kansas**2 WATER WELL OWNER: **Estate of William Wendell**RR#, St. Address, Box # : **2500 Wilson Blvd #303**City, State, ZIP Code : **Arlington, Virginia 22201**

Board of Agriculture, Division of Water Resources

Application Number:

## 3 LOCATE WELL'S LOCATION WITH AN "X" IN SECTION BOX:

4 DEPTH OF COMPLETED WELL **45** ft. ELEVATION: **2273.55**Depth(s) Groundwater Encountered 1. **39** ft. 2. **37.1** ft. 3. **3/21/96** ft.WELL'S STATIC WATER LEVEL **37.1** ft. below land surface measured on mo/day/yr **3/21/96**Pump test data: Well water was **NA** ft. after **NA** hours pumping **NA** gpmEst. Yield **NA** gpm: Well water was **NA** ft. after **NA** hours pumping **NA** gpmBore Hole Diameter **8** in. to **45** ft. and **NA** in. to **NA** ft.

WELL WATER TO BE USED AS: 5 Public water supply 8 Air conditioning 11 Injection well

1 Domestic 3 Feedlot 6 Oil field water supply 9 Dewatering 12 Other (Specify below)

2 Irrigation 4 Industrial 7 Lawn and garden only **10 Monitoring well**Was a chemical/bacteriological sample submitted to Department? Yes **No**; If yes, mo/day/yr sample was submitted Water Well Disinfected? Yes **No**

## 5 TYPE OF BLANK CASING USED:

1 Steel 3 RMP (SR) 5 Wrought iron 8 Concrete tile CASING JOINTS: Glued **Clamped****2** PVC 4 ABS 7 Fiberglass 9 Other (specify below) Welded **Threaded**Blank casing diameter **2** in. to **30** ft. Dia **2** in. to **30** ft. Dia **2** in. to **30** ft. DiaCasing height above land surface **-1.92** in., weight **1.92** lbs./ft. Wall thickness or gauge No. **Sch. 40**

## TYPE OF SCREEN OR PERFORATION MATERIAL

1 Steel 3 Stainless steel 5 Fiberglass **7** PVC 10 Asbestos-cement

2 Brass 4 Galvanized steel 6 Concrete tile 8 RMP (SR) 11 Other (specify)

SCREEN OR PERFORATION OPENINGS ARE: 5 Gauzed wrapped 8 Saw cut 11 None (open hole)

1 Continuous slot **3** Mill slot 6 Wire wrapped 9 Drilled holes

2 Louvered shutter 4 Key punched 7 Torch cut 10 Other (specify)

SCREEN-PERFORATED INTERVALS: From **30** ft. to **45** ft. From **30** ft. to **45** ft. From **30** ft. to **45** ft.GRAVEL PACK INTERVALS: From **28** ft. to **45** ft. From **28** ft. to **45** ft. From **28** ft. to **45** ft.7 CONTRACTOR'S OR LANDOWNER'S CERTIFICATION: This water well was **(1)** constructed, (2) reconstructed, or (3) plugged under my jurisdiction and was completed on (mo/day/year) **3/11/96** and this record is true to the best of my knowledge and belief.Kansas Water Well Contractor's License No. **527** This Water Well Record was completed on (mo/day/yr) **3/28/96**under the business name of **GeoCore Services, Inc.** by (signature) **GeoCore**