WATER WELL RECORD Form WWC-5 KSA 82a-1212 MW5

1 LOCATION OF WATER WELL: County: Norton | Fraction: NW ¼ SW ¼ NE ¼ | Section Number: 34 | Township Number: T 2 S | Range Number: R 23 E/W

Distance and direction from nearest town or city street address of well if located within city?
272.5' E. N. E. of intersection of highway 36/383 and Brown Ave., Norton KS

2 WATER WELL OWNER: Vern Jacobs
RR#, St. Address, Box # : 607 West Holme
City, State, ZIP Code : Norton, KS 67654
Board of Agriculture, Division of Water Resources
Application Number:

3 LOCATE WELL'S LOCATION WITH AN "X" IN SECTION BOX:

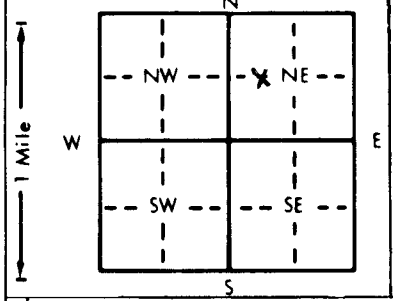

4 DEPTH OF COMPLETED WELL 74.48 ft. ELEVATION: 2342.55 (Rim)
Depth(s) Groundwater Encountered 1. 71.5 ft. 2. ft. 3. ft.
WELL'S STATIC WATER LEVEL 69.57 ft. below land surface measured on mo/day/yr 4/17/97
Pump test data: Well water was ft. after hours pumping gpm
Est. Yield gpm: Well water was ft. after hours pumping gpm
Bore Hole Diameter 8.5 in. to 75.3 ft., and in. to ft.
WELL WATER TO BE USED AS: 5 Public water supply 8 Air conditioning 11 Injection well
1 Domestic 3 Feedlot 6 Oil field water supply 9 Dewatering 12 Other (Specify below)
2 Irrigation 4 Industrial 7 Lawn and garden only 10 Monitoring well Abandoned / Plugged
Was a chemical/bacteriological sample submitted to Department? Yes No X; If yes, mo/day/yr sample was submitted
Water Well Disinfected? Yes X No

5 TYPE OF BLANK CASING USED: 5 Wrought iron 8 Concrete tile CASING JOINTS: Glued Clamped
1 Steel 3 RMP (SR) 6 Asbestos-Cement 9 Other (specify below) Welded
2 PVC 4 ABS 7 Fiberglass Threaded 2TPI
Blank casing diameter 2.375 in. to 54.3 ft., Dia in. to ft., Dia in. to ft.
Casing height above land surface -3.6 in., weight .645 lbs./ft. Wall thickness or gauge No. .154

TYPE OF SCREEN OR PERFORATION MATERIAL: 7 PVC 10 Asbestos-cement
1 Steel 3 Stainless steel 5 Fiberglass 8 RMP (SR) 11 Other (specify)
2 Brass 4 Galvanized steel 6 Concrete tile 9 ABS 12 None used (open hole)

SCREEN OR PERFORATION OPENINGS ARE: 5 Gauzed wrapped 8 Saw cut 11 None (open hole)
1 Continuous slot 3 Mill slot 6 Wire wrapped 9 Drilled holes
2 Louvered shutter 4 Key punched 7 Torch cut 10 Other (specify)

SCREEN-PERFORATED INTERVALS: From 54.3 ft. to 74.3 ft., From ft. to ft.
From ft. to ft., From ft. to ft.
GRAVEL PACK INTERVALS: From 52 ft. to 74.6 ft., From ft. to ft.
From ft. to ft., From ft. to ft.

6 GROUT MATERIAL: 1 Neat cement 2 Cement grout 3 Bentonite 4 Other
Grout Intervals: From 1 ft. to 52 ft., From ft. to ft., From ft. to ft.

What is the nearest source of possible contamination:
1 Septic tank 4 Lateral lines 7 Pit privy 10 Livestock pens 14 Abandoned water well
2 Sewer lines 5 Cess pool 8 Sewage lagoon 11 Fuel storage (home) 15 Oil well/Gas well
3 Watertight sewer lines 6 Seepage pit 9 Feedyard 12 Fertilizer storage 16 Other (specify below)
13 Insecticide storage
Direction from well? North west How many feet? 57.5

FROM	TO	LITHOLOGIC LOG	FROM	TO	PLUGGING INTERVALS
0	48	lt. brown clayey silt to sandy silt			0-3 Silty Clay
48	51	lt. brown sandy silt			3-74 Bentonite
51	71.5	lt. brown sand			
71.5	72	lt. gray brown sandy silt			
72	73	lt. red coarse gravel			
73	74	Bronish yellow clay & weathered shale			
74	74.5	Yellow brown sand & gravel			
74.5		Bronish yellow lime stone			

7 CONTRACTOR'S OR LANDOWNER'S CERTIFICATION: This water well was (1) constructed, (2) reconstructed, or (3) plugged under my jurisdiction and was completed on (mo/day/year) 12/18/97 and this record is true to the best of my knowledge and belief. Kansas Water Well Contractor's License No. 594 This Water Well Record was completed on (mo/day/yr) 12/22/97 under the business name of Coronco Inc. by (signature)

INSTRUCTIONS: Use typewriter or ball point pen. PLEASE PRESS FIRMLY and PRINT clearly. Please fill in blanks, underline or circle the correct answers. Send top three copies to Kansas Department of Health and Environment, Bureau of Water, Topeka, Kansas 66620-0001. Telephone: 913-296-5545. Send one to WATER WELL OWNER and retain one for your records.