


1 LOCATION OF WATER WELL: Fraction NW ¼ NW ¼ SW ¼ Section Number 25 Township Number T 2 S Range Number R 23 (EW)

Distance and direction from nearest town or city street address of well if located within city?

3/4 mile East & 1 mile North of Norton, Kansas

2 WATER WELL OWNER: Norton County
 RR#, St. Address, Box # : Norton County Courthouse Board of Agriculture, Division of Water Resources
 City, State, ZIP Code : Norton, Kansas 67654 Application Number:

3 LOCATE WELL'S LOCATION WITH AN "X" IN SECTION BOX:

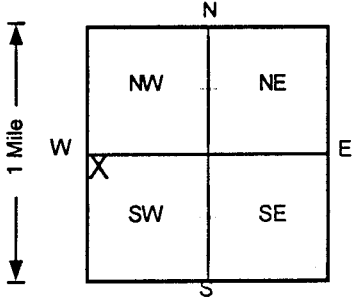

4 DEPTH OF COMPLETED WELL 26 ft ELEVATION: 2236.49
 Depth(s) Groundwater Encountered 1. 999 ft 2. ft 3. ft
 WELL'S STATIC WATER LEVEL 21.05 ft below land surface measured on mo/day/yr 5/1/97
 Pump test data: Well water was NA ft after hours pumping gpm
 Est. Yield NA gpm: Well water was ft after hours pumping gpm
 Bore Hole Diameter 8 in. to 26 ft, and in. to ft
 WELL WATER TO BE USED AS: 5 Public water supply 8 Air conditioning 11 Injection well
 1 Domestic 3 Feedlot 6 Oil field water supply 9 Dewatering 12 Other (Specify below)
 2 Irrigation 4 Industrial 7 Lawn and garden only (10) Monitoring well
 Was a chemical/bacteriological sample submitted to Department? Yes.....No (checked).....; If yes, mo/day/yr sample was submitted
 Water Well Disinfected? Yes No (checked)

5 TYPE OF BLANK CASING USED:
 1 Steel 3 RMP (SR) 5 Wrought iron 8 Concrete tile CASING JOINTS: Glued Clamped
 2 PVC 4 ABS 6 Asbestos-Cement 9 Other (specify below) Welded
 7 Fiberglass Threaded (checked)
 Blank casing diameter 2 in. to 11 ft, Dia in. to ft, Dia in. to ft
 Casing height above land surface 30.48 in., weight Sch 40 lbs./ft. Wall thickness or gauge No.
 TYPE OF SCREEN OR PERFORATION MATERIAL:
 1 Steel 3 Stainless steel 5 Fiberglass 7 PVC 10 Asbestos-cement
 2 Brass 4 Galvanized steel 6 Concrete tile 8 RMP (SR) 11 Other (specify)
 12 None used (open hole)
 SCREEN OR PERFORATION OPENINGS ARE:
 1 Continuous slot 3 Mill slot 5 Gauzed wrapped 8 Saw cut 11 None (open hole)
 2 Louvered shutter 4 Key punched 6 Wire wrapped 9 Drilled holes
 7 Torch cut 10 Other (specify)
 SCREEN-PERFORATED INTERVALS: From 11 ft to 26 ft, From ft to ft
 From ft to ft, From ft to ft
 GRAVEL PACK INTERVALS: From 9 ft to 26 ft, From ft to ft
 From ft to ft, From ft to ft

6 GROUT MATERIAL: 1 Neat cement 2 Cement grout 3 Bentonite 4 Other
 Grout Intervals: From 0 ft to 7 ft, From 7 ft to 9 ft, From ft to ft
 What is the nearest source of possible contamination:
 1 Septic tank 4 Lateral lines 7 Pit privy 10 Livestock pens 14 Abandoned water well
 2 Sewer lines 5 Cess pool 8 Sewage lagoon 11 Fuel storage 15 Oil well/Gas well
 3 Watertight sewer lines 6 Seepage pit 9 Feedyard 12 Fertilizer storage (16) Other (specify below)
 ...Unknown...
 Direction from well? How many feet? 0

FROM		TO		LITHOLOGIC LOG	FROM	TO	PLUGGING INTERVALS
0	6			Clay, Dark Brown/Gray			
6	26			Clay, Brown/Light Brown			

7 CONTRACTOR'S OR LANDOWNER'S CERTIFICATION: This water well was (1) constructed, (2) reconstructed, or (3) plugged under my jurisdiction and was completed on (mo/day/year) 3/12/97 and this record is true to the best of my knowledge and belief.
 Kansas Water Well Contractor's License No. 527 This Water Well Record was completed on (mo/day/yr) 5/30/97
 under the business name of GeoCore Services, Inc. by (signature)