

EW

1 LOCATION OF WATER WELL: Fraction **NW 1/4 NW 1/4 SW 1/4** Section Number **25** Township Number **T 2 S** Range Number **R 23**

County: **Norton**

Distance and direction from nearest town or city street address of well if located within city?
3/4 mile East and 1 mile North of Norton, Kansas

2 WATER WELL OWNER: **Norton County**

RR#, St. Address, Box # : **Norton County Courthouse** Board of Agriculture, Division of Water Resources
 City, State, ZIP Code : **Norton, Kansas 67654** Application Number:

3 LOCATE WELL'S LOCATION WITH AN "X" IN SECTION BOX:


4 DEPTH OF COMPLETED WELL **45** ft. ELEVATION: **2258.09**

Depth(s) Groundwater Encountered 1. **35** ft 2. ft 3. ft

WELL'S STATIC WATER LEVEL **28.79** ft below land surface measured on mo/day/yr **5/1/97**
 Pump test data: Well water was **NA** ft. after _____ hours pumping _____ gpm
 Est. Yield **NA** gpm: Well water was _____ ft. after _____ hours pumping _____ gpm
 Bore Hole Diameter **8** in. to **45** ft, and _____ in. to _____ ft.

WELL WATER TO BE USED AS: 5 Public water supply 8 Air conditioning 11 Injection well
 1 Domestic 3 Feedlot 6 Oil field water supply 9 Dewatering 12 Other (Specify below)
 2 Irrigation 4 Industrial 7 Lawn and garden only **10** Monitoring well

Was a chemical/bacteriological sample submitted to Department? Yes _____ No ; If yes, mo/day/yr sample was submitted _____
 Water Well Disinfected? Yes _____ No

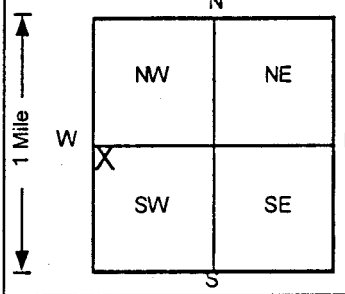

5 TYPE OF BLANK CASING USED:

1 Steel 3 RMP (SR) 5 Wrought iron 8 Concrete tile CASING JOINTS: Glued _____ Clamped _____
 2 PVC 4 ABS 6 Asbestos-Cement 9 Other (specify below) Welded _____
7 Fiberglass _____ Threaded

Blank casing diameter **2** in. to **25** ft, Dia _____ in. to _____ ft, Dia _____ in. to _____ ft.
 Casing height above land surface **11.76** in., weight **Sch 40** lbs./ft. Wall thickness or gauge No. _____

TYPE OF SCREEN OR PERFORATION MATERIAL: **7** PVC 10 Asbestos-cement
 1 Steel 3 Stainless steel 5 Fiberglass 8 RMP (SR) 11 Other (specify) _____
 2 Brass 4 Galvanized steel 6 Concrete tile 9 ABS 12 None used (open hole)

SCREEN OR PERFORATION OPENINGS ARE: 5 Gauzed wrapped 8 Saw cut 11 None (open hole)
 1 Continuous slot **3** Mill slot 6 Wire wrapped 9 Drilled holes
 2 Louvered shutter 4 Key punched 7 Torch cut 10 Other (specify) _____

SCREEN-PERFORATED INTERVALS: From **25** ft to **45** ft, From _____ ft to _____ ft
 From _____ ft to _____ ft, From _____ ft to _____ ft

GRAVEL PACK INTERVALS: From **22** ft to **45** ft, From _____ ft to _____ ft
 From _____ ft to _____ ft, From _____ ft to _____ ft

6 GROUT MATERIAL: 1 Neat cement **2** Cement grout **3** Bentonite 4 Other _____

Grout intervals: From **0** ft to **20** ft, From **20** ft to **22** ft, From _____ ft to _____ ft

What is the nearest source of possible contamination:

1 Septic tank 4 Lateral lines 7 Pit privy 10 Livestock pens 14 Abandoned water well
 2 Sewer lines 5 Cess pool 8 Sewage lagoon 11 Fuel storage 15 Oil well/Gas well
 3 Watertight sewer lines 6 Seepage pit 9 Feedyard 12 Fertilizer storage **16** Other (specify below)
 _____ Insecticide storage _____ **Unknown**

Direction from well? _____ How many feet? **0**

FROM	TO	LITHOLOGIC LOG	FROM	TO	PLUGGING INTERVALS
0	2	Clay, Dark Brown			
2	34	Clay, Light Brown			
34	45	Clay, Yellow			

7 CONTRACTOR'S OR LANDOWNER'S CERTIFICATION: This water well was **1** constructed, (2) reconstructed, or (3) plugged under my jurisdiction and was completed on (mo/day/year) **2/20/97** and this record is true to the best of my knowledge and belief.

Kansas Water Well Contractor's License No. **527** This Water Well Record was completed on (mo/day/yr) **5/30/97**
 under the business name of **GeoCore Services, Inc.** by (signature) *[Signature]*

OFFICE USE ONLY

T

R

EW

SEC.

1/2

1/2

1/2