

Well #1


WATER WELL RECORD Form WWC-5 KSA 82a-1212 ID No.

1 LOCATION OF WATER WELL: Fraction SE 1/4 SE 1/4 SE 1/4 Section Number 26 Township Number T 2 S Range Number R 23 E/W

Distance and direction from nearest town or city street address of well if located within city? 1/4 mile E. of Norton

2 WATER WELL OWNER: Rich Miller RR#, St. Address, Box #: 810 Valley Vis City, State, ZIP Code: Norton, KS 67654

3 LOCATE WELL'S LOCATION WITH 4 DEPTH OF COMPLETED WELL 68 ft. ELEVATION:

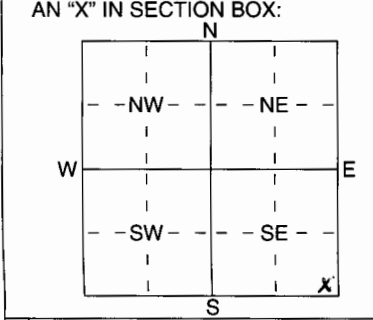

Depth(s) Groundwater Encountered 1 ft. 2 ft. 3 ft. WELL'S STATIC WATER LEVEL 36.5 ft. below land surface measured on mo/day/yr 5/31/06 Pump test data: Well water was ... ft. after ... hours pumping ... gpm Est. Yield 10 gpm: Well water was ... ft. after ... hours pumping ... gpm WELL WATER TO BE USED AS: 5 Public water supply 8 Air conditioning 11 Injection well 1 Domestic 3 Feedlot 6 Oil field water supply 9 Dewatering 12 Other (Specify below) 2 Irrigation 4 Industrial 7 Domestic (lawn & garden) 10 Monitoring well LIVESTOCK

5 TYPE OF BLANK CASING USED: 1 Steel 3 RMP (SR) 5 Wrought iron 8 Concrete tile CASING JOINTS: Glued Clamped 2 PVC 4 ABS 6 Asbestos-Cement 9 Other (specify below) Welded Threaded 7 Fiberglass

Blank casing diameter 4 in. to ... ft., Dia ... in. to ... ft., Dia ... in. to ... ft. Casing height above land surface 24 in., weight ... lbs./ft. Wall thickness or gauge No. 173

TYPE OF SCREEN OR PERFORATION MATERIAL: 1 Steel 3 Stainless Steel 5 Fiberglass 8 RMP (SR) 10 Asbestos-Cement 2 Brass 4 Galvanized Steel 6 Concrete tile 9 ABS 11 Other (Specify) 12 None used (open hole)

SCREEN OR PERFORATION OPENINGS ARE: 1 Continuous slot 3 Mill slot 5 Gauzed wrapped 8 Saw cut 11 None (open hole) 2 Louvered shutter 4 Key punched 6 Wire wrapped 9 Drilled holes 7 Torch cut 10 Other (specify) ft.

SCREEN-PERFORATED INTERVALS: From 58 ft. to 68 ft. From 0 ft. to 6 ft. From clay ft. to ft. GRAVEL PACK INTERVALS: From 6 ft. to 20 ft. From Bentonite gravel ft. to ft. From 20 ft. to 68 ft.

6 GROUT MATERIAL: 1 Neat cement 2 Cement grout 3 Bentonite 4 Other Grout Intervals: From 0 ft. to 6 clay ft. From 6 ft. to 20 ft. From ft. to ft.

What is the nearest source of possible contamination: 1 Septic tank 4 Lateral lines 7 Pit privy 10 Livestock pens 14 Abandoned water well 2 Sewer lines 5 Cess pool 8 Sewage lagoon 11 Fuel storage 15 Oil well/Gas well 3 Watertight sewer lines 6 Seepage pit 9 Feedyard 12 Fertilizer storage 16 Other (specify below) 13 Insecticide storage

Direction from well? How many feet?

Table with columns: FROM, TO, LITHOLOGIC LOG, FROM, TO, PLUGGING INTERVALS. Rows include: 0-26 soil and clay, 26-56 blue mud soft, 56-61 fine to coarse sand, some clay, 61-66 fine to coarse sand, some small gravel & some flint, 66-72 shale.

7 CONTRACTOR'S OR LANDOWNER'S CERTIFICATION: This water well was (1) constructed, (2) reconstructed, or (3) plugged under my jurisdiction and was completed on (mo/day/year) 5-24-06 and this record is true to the best of my knowledge and belief. Kansas Water Well Contractor's Licence No 495 This Water Well Record was completed on (mo/day/yr) 6-6-06 under the business name of Burton Well Drilling by (signature) Gene P. Stult

INSTRUCTIONS: Use typewriter or ball point pen. PLEASE PRESS FIRMLY and PRINT clearly. Please fill in blanks, underline or circle the correct answers. Send top three copies to Kansas Department of Health and Environment, Bureau of Water, Geology Section, 1000 SW Jackson St., Suite 420, Topeka, Kansas 66612-1367. Telephone 785-298-5522. Send one to WATER WELL OWNER and retain one for your records. Fee of \$5.00 for each constructed well.