

CORRECTION(S) TO WATER WELL RECORD (WWC-5)

(to rectify lacking or incorrect information)

County: Norton

Location listed as:

Location changed to:

Section-Township-Range: 34-25S-23W

34-25-23W

Fraction (1/4 1/4 1/4): NE SE SE

NE SE SE

Other changes: Initial statements: _____

Changed to: _____

Comments: _____

verification method: well owner's address, city street map, and mapping tool on KGS website.

initials: DRK date: 9/17/2009

submitted by: Kansas Geological Survey, Data Resources Library, 1930 Constant Ave., Lawrence, KS 66047-3726
to: Kansas Dept of Health & Environment, Bureau of Water, 1000 SW Jackson, Suite 420, Topeka, KS 66612-1367.


WATER WELL PLUGGING RECORD Form WWC-5P KSA 82a-1212 ID NO.

MW-6

1 LOCATION OF WATER WELL: County: Norton	Fraction NE ¼ SE ¼ SE ¼	Section Number 34	Township Number 25S	Range Number 23 W
--	----------------------------	----------------------	------------------------	----------------------

Distance and direction from nearest town or city street address of well if located within city?
~~Well was located at the Jefferson/Douglas County Landfill located NW of Lawrence Kansas approximately 5 miles~~ **DRL 9/17/2009**

2 WATER WELL OWNER: Norton County Coop RR#, St. Address, Box #: 201 W. Lincoln City, State ZIP Code: Norton, Ks	Global Positioning Systems (decimal degrees, min. of 4 digits) Latitude: _____ Longitude: _____ Elevation: _____ Datum: _____ Data Collection Method: _____
---	---

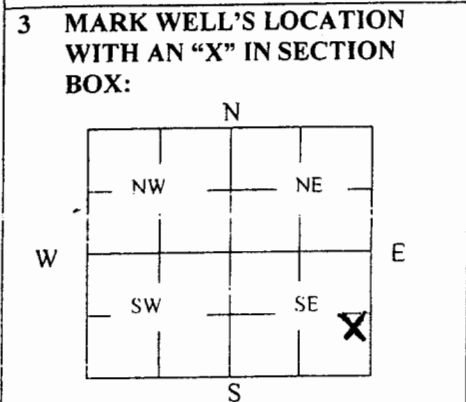

4 DEPTH OF WELL 37.80 ft.
 Well casing compromised original depth of 45.5 feet
WELL'S STATIC WATER LEVEL 37.22 ft

WELL WAS USED AS:

1 Domestic	5 Public Water Supply	9 Dewatering
2 Irrigation	6 Oil Field Water Supply	<u>10</u> Monitoring
3 Feedlot	7 Domestic (Lawn & Garden)	11 Injection Well
4 Industrial	8 Air Conditioning	12 Other _____

Was a chemical/bacteriological sample submitted to Department? Yes _____ No x

5 TYPE OF BLANK CASING USED:

1 Steel	3 RMP (SR)	5 Wrought	7 Fiberglass	9 Other (Specify below)
<u>2</u> PVC	4 ABS	6 Asbestos-Cement	8 Concrete Tile	_____

Blank casing diameter 2 in. Was casing pulled? Yes x No _____ If yes, how much 3 ft.
 Casing height above or below land surface _____ in.

6 GROUT PLUG MATERIAL: 1 Neat cement 2 Cement grout 3 Bentonite 4 Other silts/clays _____

Grout Plug Intervals: From 37.8 ft. to 3 ft., From 4 3 ft. to 0 ft., From _____ to _____ ft.

What is the nearest source of possible contamination:

1 Septic tank	6 Seepage pit	11 Fuel Storage	16 Other (specify below)
2 Sewer lines	7 Pit privy	12 Fertilizer storage	_____
3 Watertight sewer lines	8 Sewage lagoon	13 Insecticide storage	_____
4 Lateral lines	9 Feedyard	14 Abandoned water well	Direction from well? _____
5 Cess pool	10 Livestock pens	15 Oil well/Gas well	How many feet? _____

FROM	TO	PLUGGING MATERIALS	FROM	TO	PLUGGING MATERIALS
<u>37.8</u>	<u>3</u>	Bentonite			
<u>3</u>	<u>0</u>	Compacted silts/clays			
		Concrete/Asphalt			

CORRECTED

RECEIVED
MAY 07 2009
BUREAU OF WATER

7 CONTRACTOR'S OR LANDOWNER'S CERTIFICATION: This water well was plugged under my jurisdiction and was completed on (mo/day/year) 3/31/09 and this record is true to the best of my knowledge and belief. Kansas Water Well Contractor's License No. 585. This Water Well Record was completed on (mo/day/year) 9/17/09 under the business name of Associated Environmental, Inc. by (signature) [Signature]

INSTRUCTIONS: Use typewriter or ballpoint pen. Please press firmly and print clearly. Please fill in blanks, underline or circle the correct answers. Send top three copies to Kansas Department of Health and Environment, Bureau of Water, Geology Section, 1000 SW Jackson St., Ste. 420, Topeka, Kansas 66612-1367 Telephone: 785/296-5522. Send one to Water Well Owner and retain one for your records. Visit us at <http://www.kdheks.gov/waterwell/index.htm>