

USE TYPEWRITER OR BALL POINT PEN-PRESS FIRMLY, PRINT CLEARLY.

WATER WELL RECORD
KSA 82a-1201-1215


Kansas Department of Health and Environment-Division of Environment (Water well Contractors) Topeka, Kansas 66620

DDD

morton

1. Location of well: County **NORTON** Fraction **SE 1/4 SE 1/4 SE 1/4** Section number **16** Township number **T 2 S R 23**

2. Distance and direction from nearest town or city: **2 miles North 1 mile West of**
Street address of well location if in city: **NORTON, KS**
3. Owner of well: **MARVIN Stutheit**
R.R. or street: **RR #1**
City, state, zip code: **NORTON, KS 67654**

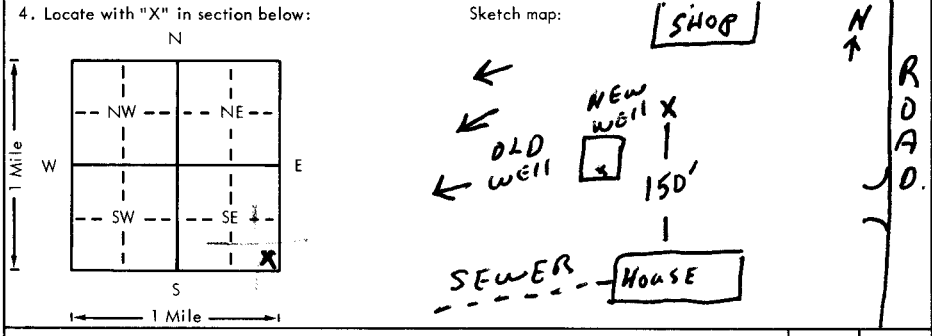

6. Bore hole dia. **9** in. Completion date **6-15-79**
Well depth **97** ft.
7. Cable tool Rotary Driven Dug
 Hollow rod Jetted Bored Reverse rotary
8. Use: Domestic Public supply Industry
 Irrigation Air conditioning Stock
 Lawn Oil field water Other
9. Casing: Material _____ Height: **Above** or below
Threaded _____ Welded _____ Surface **12** in.
RMP _____ PVC Weight **275** lbs./ft.
Dia. **5** in. to **22** ft. depth Wall Thickness: inches or
Dia. _____ in. to _____ ft. depth Gauge No. **258**

5. Type and color of material	From	To
CLAY, TAN	0	41
Rock	41	45
CLAY, white	45	67
SAND, white with. Clay	67	87
SAND tan (M)	87	97
FLint. Rock.	97	
BROCK		

10. Screen: Manufacturer's name **MODERN PIPES INC**
Type **PVC** Dia. **5"**
Slot/Space **0.30** Length **20'**
Set between **77** ft. and **97** ft.
ft. and _____ ft.
Gravel pack? **YES** Size range of material **1/8-1/4**
11. Static water level: _____ mo./day/yr.
66 ft. below land surface Date **6-29-79**
12. Pumping level below land surfaces:
_____ ft. after _____ hrs. pumping _____ g.p.m.
_____ ft. after _____ hrs. pumping _____ g.p.m.
Estimated maximum yield **20** g.p.m.
13. Water sample submitted: _____ mo./day/yr.
 Yes No Date _____
14. Well head completion:
 Pitless adapter **12** Inches above grade
15. Well grouted? **YES**
With: _____ Neat cement _____ Bentonite _____ Concrete
Depth: From **5** ft. to **15** ft.
16. Nearest source of possible contamination:
ft. **150** Direction **SW** Type **SEWER**
Well disinfected upon completion? Yes No
17. Pump: _____ Not installed
Manufacturer's name **AER motor**
Model number **SD12** HP **3/4** Volts **230**
Length of drop pipe **85** ft. capacity **12** g.p.m.
Type:
 Submersible Turbine
 Jet Reciprocating
 Centrifugal Other

18. Elevation: _____
Topography: _____ Hill Slope _____ Upland _____ Valley
19. Remarks: **2375**
20. Water well contractor's certification:
This well was drilled under my jurisdiction and this report is true to the best of my knowledge and belief.
Fawcett Drilling **167**
Business name License No.
Address **RR #3 Norton, KS**
Signed **M. Stutheit** Date _____
Authorized representative

T 23 R 23 S 23 E 16 Sec 16 SE 23 SE 1/4 1/4 1/4