


1 LOCATION OF WATER WELL: County: Norton	Fraction NW 1/4 NE 1/4 SW 1/4	Section Number 25	Township Number T 2 S	Range Number R 23 EW
---	----------------------------------	----------------------	--------------------------	-------------------------

Distance and direction from nearest town or city street address of well if located within city?
Approximately 1 1/2 miles east and 1 1/2 mile north of Norton KS

2 WATER WELL OWNER: Northon County Landfill
 RR#, St. Address, Box #: P.O. Box 10
 City, State, ZIP Code: Norton County Court House, Norton KS 67654
 Board of Agriculture, Division of Water Resources
 Application Number: N/A

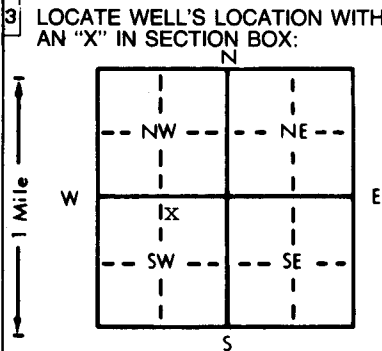

4 DEPTH OF COMPLETED WELL: 98 ft. ELEVATION: unknown

Depth(s) Groundwater Encountered 1. ft. 2. ft. 3. ft.

WELL'S STATIC WATER LEVEL 7.8 ft. below land surface measured on mo/day/yr

Pump test data: Well water was Not Ch'd ft. after hours pumping gpm

Est. Yield unknown gpm: Well water was ft. after hours pumping gpm

Bore Hole Diameter 9 in. to 9.8 ft., and in. to ft.

WELL WATER TO BE USED AS:

5 Public water supply	8 Air conditioning	11 Injection well
1 Domestic	3 Feedlot	6 Oil field water supply
2 Irrigation	4 Industrial	7 Lawn and garden only
		10 Monitoring well
		9 Dewatering
		12 Other (Specify below)

Was a chemical/bacteriological sample submitted to Department? Yes No ; If yes, mo/day/yr sample was submitted

Water Well Disinfected? Yes No

5 TYPE OF BLANK CASING USED:

1 Steel	3 RMP (SR)	5 Wrought iron	8 Concrete tile	CASING JOINTS: Glued <input checked="" type="checkbox"/> Clamped
2 PVC	4 ABS	6 Asbestos-Cement	9 Other (specify below)	Welded
		7 Fiberglass		Threaded

Blank casing diameter 4 in. to 7.0 ft., Dia in. to in. to ft.

Casing height above land surface 24 in., weight 2.07 lbs./ft. Wall thickness or gauge No. 237

TYPE OF SCREEN OR PERFORATION MATERIAL:

1 Steel	3 Stainless steel	5 Fiberglass	7 PVC	10 Asbestos-cement
2 Brass	4 Galvanized steel	6 Concrete tile	8 RMP (SR)	11 Other (specify)
			9 ABS	12 None used (open hole)

SCREEN OR PERFORATION OPENINGS ARE:

1 Continuous slot	3 Mill slot	5 Gauzed wrapped	8 Saw cut	11 None (open hole)
2 Louvered shutter	4 Key punched	6 Wire wrapped	9 Drilled holes	
		7 Torch cut	10 Other (specify)	

SCREEN-PERFORATED INTERVALS: From 7.0 ft. to 9.8 ft., From ft. to ft.

GRAVEL PACK INTERVALS: From 6.8 ft. to 9.8 ft., From ft. to ft.

6 GROUT MATERIAL: 1 Neat cement 2 Cement grout 3 Bentonite 4 Other Bentonite Hole Plug

Grout intervals: From ft. to ft., From ft. to ft., From 0 ft. to 6.8 ft.

What is the nearest source of possible contamination:

1 Septic tank	4 Lateral lines	7 Pit privy	10 Livestock pens	14 Abandoned water well
2 Sewer lines	5 Cess pool	8 Sewage lagoon	11 Fuel storage	15 Oil well/Gas well
3 Watertight sewer lines	6 Seepage pit	9 Feedyard	12 Fertilizer storage	16 Other (specify below)
			13 Insecticide storage	Trash Dump

Direction from well? West How many feet? 75'

FROM	TO	LITHOLOGIC LOG	FROM	TO	PLUGGING INTERVALS
0	4	Topsoil			
4	50	Clay, Tan soft, sandy			
50	56	Streaks of sand and gravel med. and streaks of clay tan			
56	70	Clay, Brown, Soft, Sandy			
70	79.5	Sand & Gravel med. some coarse with thin clay streaks			
79.5	94	Clay, Orange and Yellow			
94	98	Shale, Black			

7 CONTRACTOR'S OR LANDOWNER'S CERTIFICATION: This water well was (1) constructed, (2) reconstructed, or (3) plugged under my jurisdiction and was completed on (mo/day/year) 3/17/89 and this record is true to the best of my knowledge and belief. Kansas Water Well Contractor's License No. 185 This Water Well Record was completed on (mo/day/yr) 3/31/89 under the business name of Clarke Well & Equipment, Inc. by (signature) *[Signature]*