USE TYPEWRITER OR BALL POINT PEN-PRESS FIRMLY, PRINT CLEARLY.

WATER WELL RECORD
KSA 82a-1201-1215

Kansas Department of Health and Environment-Division of Environment
(Water well Contractors)
Topeka, Kansas 66620

CDC

1. Location of well:	County	Fraction	Section number	Township number	Range number
	Norton	SW 1/4 SE 1/4 SW 1/4	33	T 2 S	R 23 E/W

2. Distance and direction from nearest town or city: From intersection of Hwy 283 & 36,2 Mi. W. on Hwy 36, North side of Rd.
Street address of well location if in city:

3. Owner of well: Leslie LeCount
R.R. or street: Rt 3
City, state, zip code: Norton, Ks. 67654

4. Locate with "X" in section below:

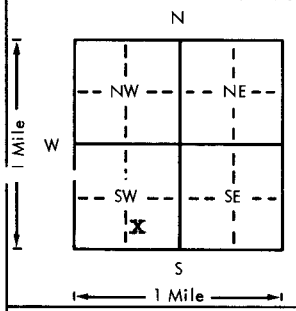

Sketch map:

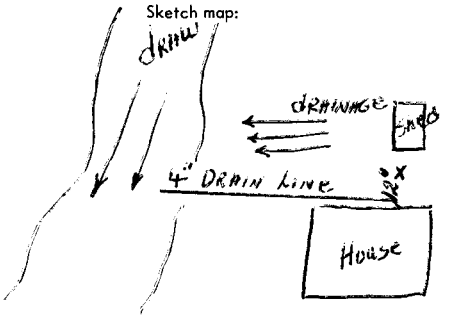

6. Bore hole dia. 8.5 in. Completion date 2-25-77
Well depth 52 ft.

7. X Cable tool __ Rotary __ Driven __ Dug
__ Hollow rod __ Jetted __ Bored __ Reverse rotary

8. Use: X Domestic __ Public supply __ Industry
__ Irrigation __ Air conditioning __ Stock
__ Lawn __ Oil field water __ Other

9. Casing: Material Plastic Height: Above or below
Threaded ___ Welded Glue Surface 12 in.
RMP ___ PVC X Weight ___ lbs./ft.
Dia. 5 in. to 52 ft. depth Wall Thickness: inches or
Dia. ___ in. to ___ ft. depth gage No. Sch 40

5. Type and color of material	From	To
Top Soil	0	3
Yellow Clay	3	18
Fine Sand	18	28
Medium Sand	28	30
Flint Rock	30	31
Yellow Clay	31	33
Flint Rock	33	35
Yellow - Orange Clay	35	50
Shale	50	52
35 ?		
35' (Cal)		
35		
0		
1. Alluvium		
2260'		

(Use a second sheet if needed)

10. Screen: Manufacturer's name
Modern Pipes Inc.
Type PVC Dia. 5"
Slot/Gauge .030 Length 20'
Set between 32 ft. and 52 ft.
___ ft. and ___ ft.
Gravel pack? Yes Size range of material 1/4 - 1/8"

11. Static water level: mo./day/yr.
35 ft. below land surface Date 2-25-77

12. Pumping level below land surfaces:
___ ft. after ___ hrs. pumping ___ g.p.m.
___ ft. after ___ hrs. pumping ___ g.p.m.
Estimated maximum yield 5 g.p.m.

13. Water sample submitted: mo./day/yr.
___ Yes X No Date ___

14. Well head completion:
___ Pitless adapter 12 Inches above grade

15. Well grouted? yes
With: X Neat cement ___ Bentonite ___ Concrete
Depth: From 14 ft. to 4 ft.

16. Nearest source of possible contamination: Cast Iron
ft. 12 Direction south Type Sewer
Well disinfected upon completion? X Yes ___ No

17. Pump: X Not installed
Manufacturer's name ___
Model number ___ HP ___ Volts ___
Length of drop pipe ___ ft. capacity ___ g.p.m.
Type:
___ Submersible ___ Turbine
___ Jet ___ Reciprocating
___ Centrifugal ___ Other

18. Elevation:

Topography:
___ Hill
X Slope
___ Upland
___ Valley

19. Remarks: 2295 (TOPO)
Customer will install concrete slab
He knows this is a regulation

20. Water well contractor's certification:
This well was drilled under my jurisdiction and this report is true to the best of my knowledge and belief.
Deer Drilling 344
Business name License No.
Address RFD 4 Phillipsburg, Ks.
Signed William J. Deer Date 3-5-77
Authorized representative

T 2 R 23 E/W Sec 33 1/4 SW 1/4 SE 1/4 SW

Forward the white, blue and pink copies to the Department of Health and Environment

Form WWC-5