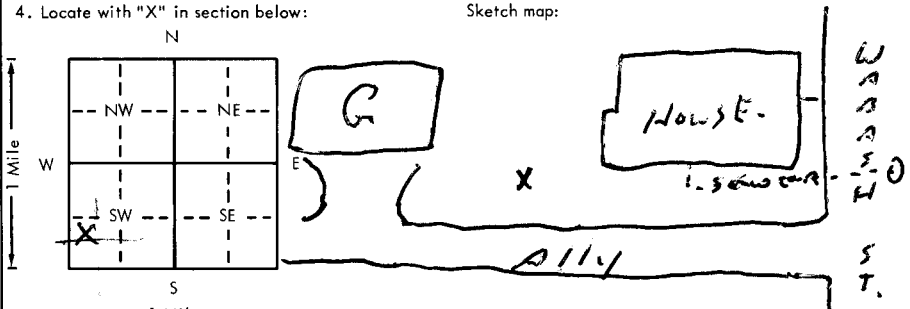


USE TYPEWRITER OR BALL
POINT PEN-PRESS FIRMLY,
PRINT CLEARLY.

WATER WELL RECORD
KSA 82a-1201-1215

Kansas Department of Health and
Environment-Division of Environment
(Water well Contractors)
Topeka, Kansas 66620

1. Location of well: Norton		X fraction SW of SW NW 1/4 1/4 1/4		Section number 35	Township number T 2 S R 23	Range number 23
2. Distance and direction from nearest town or city: INSIDE Norton city limits Street address of well location if in city:				3. Owner of well: George Witter. R.R. or street: 208 N. WABASH City, state, zip code: Norton KS 67654.		
4. Locate with "X" in section below: 				6. Bore hole dia. 9 in. Completion date 6-8-78 Well depth 62 ft.		
5. Type and color of material				7. <input checked="" type="checkbox"/> Cable tool <input checked="" type="checkbox"/> Rotary <input type="checkbox"/> Driven <input type="checkbox"/> Dig <input type="checkbox"/> Hollow rod <input type="checkbox"/> Jetted <input type="checkbox"/> Bored <input type="checkbox"/> Reverse rotary		
				8. Use: <input checked="" type="checkbox"/> Domestic <input type="checkbox"/> Public supply <input type="checkbox"/> Industry <input type="checkbox"/> Irrigation <input type="checkbox"/> Air conditioning <input type="checkbox"/> Stock <input type="checkbox"/> Lawn <input type="checkbox"/> Oil field water <input type="checkbox"/> Other		
From To				9. Casing: Material <input type="checkbox"/> Height <input type="checkbox"/> Above or below Threaded <input type="checkbox"/> Welded <input type="checkbox"/> Surface 12 in. RMP <input type="checkbox"/> PVC <input checked="" type="checkbox"/> Weight 275 lbs./ft. Dia. 5 in. to 53 ft. depth Wall Thickness: inches or Dia. <input type="checkbox"/> in. to <input type="checkbox"/> ft. depth gage No. 358		
				10. Screen: Manufacturer's name MODERN PIPES INC Type PVC Dia. 5" Slot 0.30 Length 10' Set between 52 ft. and 62 ft. ft. and ft. Gravel pack? YES Size range of material 14-14		
BROCK 59'				11. Static water level: <input type="checkbox"/> mo./day/yr. 45 ft. below land surface Date 6-8-78		
				12. Pumping level below land surfaces: ft. after hrs. pumping g.p.m. ft. after hrs. pumping g.p.m. Estimated maximum yield 15 g.p.m.		
in Alluvium				13. Water sample submitted: <input type="checkbox"/> mo./day/yr. <input checked="" type="checkbox"/> Yes <input checked="" type="checkbox"/> No Date		
				14. Well head completion: <input checked="" type="checkbox"/> Pitless adapter 12 Inches above grade		
2276				15. Well grouted? YES With: <input type="checkbox"/> Neat cement <input type="checkbox"/> Bentonite <input checked="" type="checkbox"/> Concrete Depth: From 5 ft. to 15 ft.		
				16. Nearest source of possible contamination: ft. 50' Direction EAST Type SEWER Well disinfected upon completion? <input checked="" type="checkbox"/> Yes <input type="checkbox"/> No		
(Use a second sheet if needed)				17. Pump: <input type="checkbox"/> Not installed Manufacturer's name ACROMOTOR Model number 5012 HP 1/2 Volts 330 Length of drop pipe 51 ft. capacity 12 g.p.m. Type: <input checked="" type="checkbox"/> Submersible <input type="checkbox"/> Turbine <input type="checkbox"/> Jet <input type="checkbox"/> Reciprocating <input type="checkbox"/> Centrifugal <input type="checkbox"/> Other		
				20. Water well contractor's certification: This well was drilled under my jurisdiction and this report is true to the best of my knowledge and belief. Ernest T Drilling 167 Business name License No. Address Box 149 Norton KS Signed [Signature] Date 6-25-78 Authorized representative		
18. Elevation: Topography: <input checked="" type="checkbox"/> Hill <input type="checkbox"/> Slope <input type="checkbox"/> Upland <input type="checkbox"/> Valley		19. Remarks: 2276 2211				