


1 LOCATION OF WATER WELL: Fraction Section Number Township Number Range Number  
 County: Norton SE 1/4 SE 1/4 NW 1/4 36 T 2 S R 23 EW

Distance and direction from nearest town or city street address of well if located within city?  
2 Miles East 1/4 North

2 WATER WELL OWNER: Leroys and Lila M. Atwell  
 RR#, St. Address, Box # : R.R. Box 31 Board of Agriculture, Division of Water Resources  
 City, State, ZIP Code : Norton, KS 67654 Application Number: 22,266

3 LOCATE WELL'S LOCATION WITH AN "X" IN SECTION BOX:

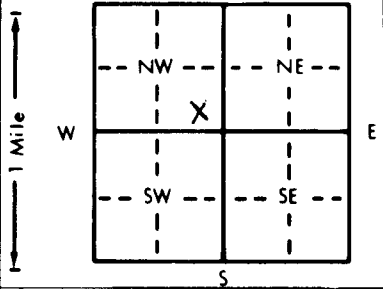

4 DEPTH OF COMPLETED WELL... 58.6 ft. ELEVATION: .....  
 Depth(s) Groundwater Encountered 1. 17' ft. 2. .... ft. 3. .... ft.  
 WELL'S STATIC WATER LEVEL ... 17 ft. below land surface measured on mo/day/yr .....  
 Pump test data: Well water was 56 ft. after 3 hours pumping 1,000 gpm  
 Est. Yield 1,000 gpm: Well water was 55 ft. after 3 hours pumping 900 gpm  
 Bore Hole Diameter: 30 in. to 58 ft., and 6 in. to ..... ft.  
 WELL WATER TO BE USED AS: 5 Public water supply 8 Air conditioning 11 Injection well  
 1 Domestic 3 Feedlot 6 Oil field water supply 9 Dewatering 12 Other (Specify below)  
 Irrigation 4 Industrial 7 Lawn and garden only 10 Monitoring well .....  
 Was a chemical/bacteriological sample submitted to Department? Yes.....No .....; If yes, mo/day/yr sample was sub-  
 mitted Water Well Disinfected? Yes  No

5 TYPE OF BLANK CASING USED: 5 Wrought iron 8 Concrete tile CASING JOINTS: Glued  Clamped .....  
 1 Steel 3 RMP (SR) 6 Asbestos-Cement 9 Other (specify below) Welded Screwed .....  
 PVC 4 ABS 7 Fiberglass Threated.....

Blank casing diameter 16 in. to 0-38 ft., Dia ..... in. to ..... ft., Dia ..... in. to ..... ft.  
 Casing height above land surface ..... in., weight ..... lbs./ft. Wall thickness or gauge No. ....

TYPE OF SCREEN OR PERFORATION MATERIAL:  PVC 10 Asbestos-cement  
 1 Steel 3 Stainless steel 5 Fiberglass 8 RMP (SR) 11 Other (specify) .....  
 2 Brass 4 Galvanized steel 6 Concrete tile 9 ABS 12 None used (open hole)

SCREEN OR PERFORATION OPENINGS ARE: 5 Gauzed wrapped  Saw cut 11 None (open hole)  
 1 Continuous slot  Mill slot 6 Wire wrapped 9 Drilled holes  
 2 Louvered shutter 4 Key punched 7 Torch cut 10 Other (specify) .....

SCREEN-PERFORATED INTERVALS: From 38.6 ft. to 58.6 ft., From ..... ft. to ..... ft.  
 From ..... ft. to ..... ft., From ..... ft. to ..... ft.  
 GRAVEL PACK INTERVALS: From 12 ft. to 58.6 ft., From ..... ft. to ..... ft.  
 From ..... ft. to ..... ft., From ..... ft. to ..... ft.

6 GROUT MATERIAL: 1 Neat cement 2 Cement grout  Bentonite 4 Other .....  
 Grout Intervals: From 0 ft. to 12 ft., From ..... ft. to ..... ft., From ..... ft. to ..... ft.

What is the nearest source of possible contamination: 10 Livestock pens 14 Abandoned water well  
 1 Septic tank 4 Lateral lines 7 Pit privy 11 Fuel storage 15 Oil well/Gas well  
 2 Sewer lines 5 Cess pool 8 Sewage lagoon 12 Fertilizer storage 16 Other (specify below)  
 3 Watertight sewer lines 6 Seepage pit 9 Feedyard 13 Insecticide storage

Direction from well? How many feet? 350"

FROM	TO	LITHOLOGIC LOG	FROM	TO	PLUGGING INTERVALS
0	15	Top Soil	0	6	Concrete
15	30	Sand Gravel Clay Thick	6	12	Bentonite
30	45	Sand Gravel Rock			
45	56	Sand gravel Thin Clay			
57	58.6	Shale			

7 CONTRACTOR'S OR LANDOWNER'S CERTIFICATION: This water well was (1)  constructed, (2) reconstructed, or (3) plugged under my jurisdiction and was completed on (mo/day/year) Dec 1, 1993 and this record is true to the best of my knowledge and belief. Kansas Water Well Contractor's License No. 215. This Water Well Record was completed on (mo/day/yr) Dec 14, 1993 under the business name of Peerless Mach. Mfg. by (signature) [Signature]

INSTRUCTIONS: Use typewriter or ball point pen. PLEASE PRESS FIRMLY and PRINT clearly. Please fill in blanks, underline or circle the correct answers. Send top three copies to Kansas Department of Health and Environment, Bureau of Water, Topeka, Kansas 66620-0001. Telephone: 913-296-5545. Send one to WATER WELL OWNER and retain one for your records.