


1 LOCATION OF WATER WELL: County: Norton	Fraction SW ¼ NE ¼ SE ¼	Section Number 34	Township Number T 2 S	Range Number R 23 W
--	---	-----------------------------	---------------------------------	-------------------------------

Distance and direction from nearest town or city street address of well if located within city?
W North St & N Grant Ave, Norton, KS

2 WATER WELL OWNER: **KDHE-BER**
RR#, St. Address, Box # : **1000 SW Jackson Ste. 410** Board of Agriculture, Division of Water Resources
City, State, ZIP Code : **Topeka, KS 66612** Application Number:

3 LOCATE WELL'S LOCATION WITH AN "X" IN SECTION BOX:

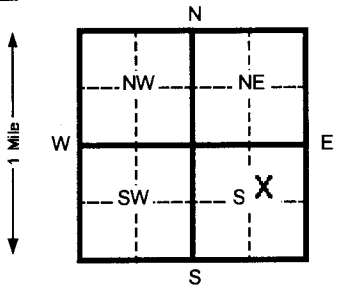

4 DEPTH OF COMPLETED WELL **45** ft. ELEVATION: **2279.24**
Depth(s) Groundwater Encountered 1.5 **39.5** ft. 2 _____ ft. 3 _____ Ft.
WELL'S STATIC WATER LEVEL **36.28** ft. below land surface measured on mo/day/yr **05/02/12**
Pump test data: Well water was _____ Ft. after _____ hours pumping _____ Gpm
Est. Yield _____ Gpm: Well water was _____ Ft. after _____ Hours pumping _____ Gpm
Bore Hole Diameter **8.625** in. to **45** ft. and _____ in. to _____ Ft.
WELL WATER TO BE USED AS: 5 Public water supply 8 Air conditioning 11 Injection well
1 Domestic 3 Feed lot 6 Oil field water supply 9 Dewatering 12 Other (Specify below)
2 Irrigation 4 Industrial 7 Lawn and garden (domestic) 10 **Monitoring well** **SWP-1**
Was a chemical/bacteriological sample submitted to Department? Yes _____ No **X** If yes, mo/day/yr sample was Submitted _____
Water Well Disinfected? Yes _____ No **X**

5 TYPE OF BLANK CASING USED: 5 Wrought Iron 8 Concrete tile CASING JOINTS: Glued _____ Clamped _____
1 Steel 3 RMP (SR) 6 Asbestos-Cement 9 Other (specify below) _____ Welded _____
2 **PVC** 4 ABS 7 Fiberglass _____ **Threaded** **X**
Blank casing diameter **2** in. to **35** Ft., Dia _____ in. to _____ ft., Dia _____ in. to _____ ft.
Casing height above land surface **FLUSH** In., weight **SCH 40** Lbs./ft. Wall thickness or gauge No. _____
TYPE OF SCREEN OR PERFORATION MATERIAL: 7 **PVC** 10 Asbestos-cement
1 Steel 3 Stainless steel 5 Fiberglass 8 RMP (SR) 11 Other (specify) _____
2 Brass 4 Galvanized steel 6 Concrete tile 9 ABS 12 None used (open hole) _____
SCREEN OR PERFORATION OPENINGS ARE: 5 Gauzed wrapped 8 Saw cut 11 None (open hole)
1 Continuous slot 3 **Mill slot** 6 Wire wrapped 9 Drilled holes
2 Louvered shutter 4 Key punched 7 Torch cut 10 Other (specify) _____
SCREEN-PERFORATED INTERVALS: From **35** ft. to **45** ft. From _____ ft. to _____ ft.
From _____ ft. to _____ ft. From _____ ft. to _____ Ft.
SAND PACK INTERVALS: From **33** ft. to **45** ft. From _____ ft. to _____ Ft.
From _____ ft. to _____ ft. From _____ ft. to _____ Ft.

6 GROUT MATERIAL: 1 Neat cement 2 **Cement grout** 3 **Bentonite** 4 Other _____
Grout Intervals From 2 **0.5** ft. to **1** Ft. From 3 **1** to **33** ft. From _____ ft. to _____ ft.
What is the nearest source of possible contamination:
1 Septic tank 4 Lateral lines 7 Pit privy 10 Livestock pens 14 Abandoned water well
2 Sewer lines 5 Cess pool 8 Sewage lagoon 11 Fuel storage 15 Oil well/ Gas well
3 Watertight sewer lines 6 Seepage pit 9 Feedyard 12 Fertilizer storage 16 **Other (specify below)**
Contaminated Site
Direction from well? _____ How many feet? _____

FROM	TO	CODE	LITHOLOGIC LOG	FROM	TO	PLUGGING INTERVALS
0	1		Silt, Clay, Gravel			
1	1.5		Silt, light brown			
1.5	5.5		Silt, dark brown			
5.5	8.5		Clay, silty			
8.5	12		Silt, Clayey			
12	40.5		Clay, silty			
40.5	45		Sand			
45	TD		End of Borehole			

7 CONTRACTOR'S OR LANDOWNER'S CERTIFICATION: This water well was (x) constructed, (2) reconstructed, or (3) plugged under my jurisdiction and w
Completed on (mo/day/yr) **04/30/12** And this record is true to the best of my knowledge and belief. Kansas
Water Well Contractor's License No. **585** This Water Well Record was completed on (mo/day/yr) **05/30/12**
under the business name of **Associated Environmental, Inc.** By (signature) **Bradley J. Johnson**
INSTRUCTIONS: Please fill in blanks and circle the correct answers. Send three copies to Kansas Department of Health and Environment, Bureau of Water, Topeka, Kansas 66620-0001. Telephone: 913-296-5545. Send one to WATER WELL OWNER and retain one for your records.

OFFICE USE ONLY

T

R

SEC