

WATER WELL RECORD

Form WWC-5

Revised

Division of Water Resources App. No.


Well ID

MW1

Original Record [] Correction [X] Change in Well Use []

1 LOCATION OF WATER WELL: County Norton, Fraction SE 1/4 SE 1/4 NW 1/4 NE 1/4, Section Number 34, Township Number T 2 S, Range Number R 23 E W

2 WELL OWNER: Last Name: First: Street or Rural Address where well is located (if unknown, distance and direction from nearest town or intersection): If at owner's address, check here: []

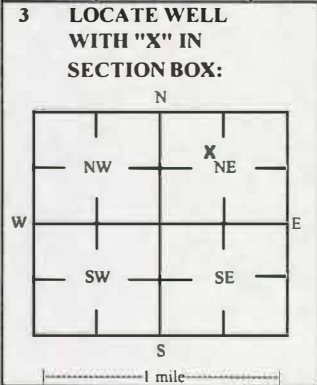

4 DEPTH OF COMPLETED WELL: 80 ft, Depth(s) Groundwater Encountered: 1) ft, 2) ft, 3) ft, or 4) Dry Well []

5 Latitude: 39.83873 (decimal degrees), Longitude: 99.89358 (decimal degrees), Horizontal Datum: [X] WGS 84 [] NAD 83 [] NAD 27

6 Elevation: 2334.79 ft [] Ground Level [X] TOC, Source: [X] Land Survey [] GPS [] Topographic Map [] Other

7 WELL WATER TO BE USED AS: 1 Domestic: [] Household [] Lawn & Garden [] Livestock [] Irrigation [] Feedlot [] Industrial

Was a chemical/bacteriological sample submitted to KDHE? [] Yes [X] No, If yes, date sample was submitted:

8 TYPE OF CASING USED: [] Steel [X] PVC [] Other, CASING JOINTS: [] Glued [] Clamped [] Welded [X] Threaded

9 GROUT MATERIAL: [] Neat cement [] Cement grout [X] Bentonite [X] Other Concrete: 0-0.5'

Nearest source of possible contamination: [] Septic Tank [] Lateral Lines [] Pit Privy [] Livestock Pens [] Insecticide Storage

Table with columns: 10 FROM, TO, LITHOLOGIC LOG, FROM, TO, LITHO. LOG (cont.) or PLUGGING INTERVALS

Notes: KDHE ID: McCormack's Service; U6-069-00154

11 CONTRACTOR'S OR LANDOWNER'S CERTIFICATION: This water well was [X] constructed, [] reconstructed or [] plugged under my jurisdiction and was completed on (mo-day-year) 5/24/22

DENNIS L HANDKE

1820 NW 59th Terrace
TOPEKA, KANSAS 66618
785-286-4047 Home

Jess Chapman
Larsen & Assoc.
1311 E. 25th St., Suite B
Topeka, Kansas 66046

June 9, 2022
Revised September 17, 2022

RE: Monitor Well Elevation Survey
407 W. Holme St., Norton, Kansas

Proj. 22-00HH
McCormack's Service
KDHE ID U6-069-00154


Bench Mark: Chisled sq. on SW corner of concrete sign base near the SE corner of property.
Elev.: 2335.02 North 3980.84 West 1308.47 (from NE Cor. Sec. 34-2-23W)


MW-1	rim	2335.07	North 4009.41	SE1/4,SE1/4,NW1/4,NE1/4
	top pipe	2334.79	West 1329.08	Lat = 39.83873 Long = 99.89358
MW-2	rim	2335.71	North 3999.15	SE1/4,SE1/4,NW1/4,NE1/4
	top pipe	2335.41	West 1425.20	Lat = 39.83870 Long = 99.89392
MW-3	rim	2335.02	North 3984.59	SE1/4,SE1/4,NW1/4,NE1/4
	top pipe	2334.64	West 1355.96	Lat = 39.83866 Long = 99.89368
MW-4	rim	2336.10	North 4085.79	SE1/4,SE1/4,NW1/4,NE1/4
	top pipe	2335.57	West 1408.08	Lat = 39.83894 Long = 99.89386
MW-5	rim	2336.16	North 3859.12	NE1/4,NE1/4,SW1/4,NE1/4
	top pipe	2335.92	West 1459.46	Lat = 39.83832 Long = 99.89405
MW-6	rim	2332.37	North 3900.95	NW1/4,NW1/4,SE1/4,NE1/4
	top pipe	2332.12	West 1157.21	Lat = 39.83843 Long = 99.89297
MW-7	rim	2334.32	North 3884.83	NW1/4,NW1/4,SE1/4,NE1/4
	top pipe	2333.94	West 1314.99	Lat = 39.83838 Long = 99.89353
MW-8	rim	2336.57	North 3976.78	SE1/4,SE1/4,NW1/4,NE1/4
	top pipe	2336.25	West 1484.43	Lat = 39.83864 Long = 99.89413
MW-9	rim	2334.89	North 3984.94	SW1/4,SW1/4,NE1/4,NE1/4
	top pipe	2334.64	West 1245.94	Lat = 39.83866 Long = 99.89328

Lat & Long derived from Norton 7.5' quad map. WGS84.

Elevation derived from NGS Station Norton. NAVD 88.

If you have any questions, please feel free to call me. Thank you for the opportunity to be

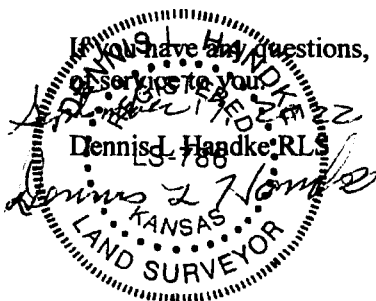

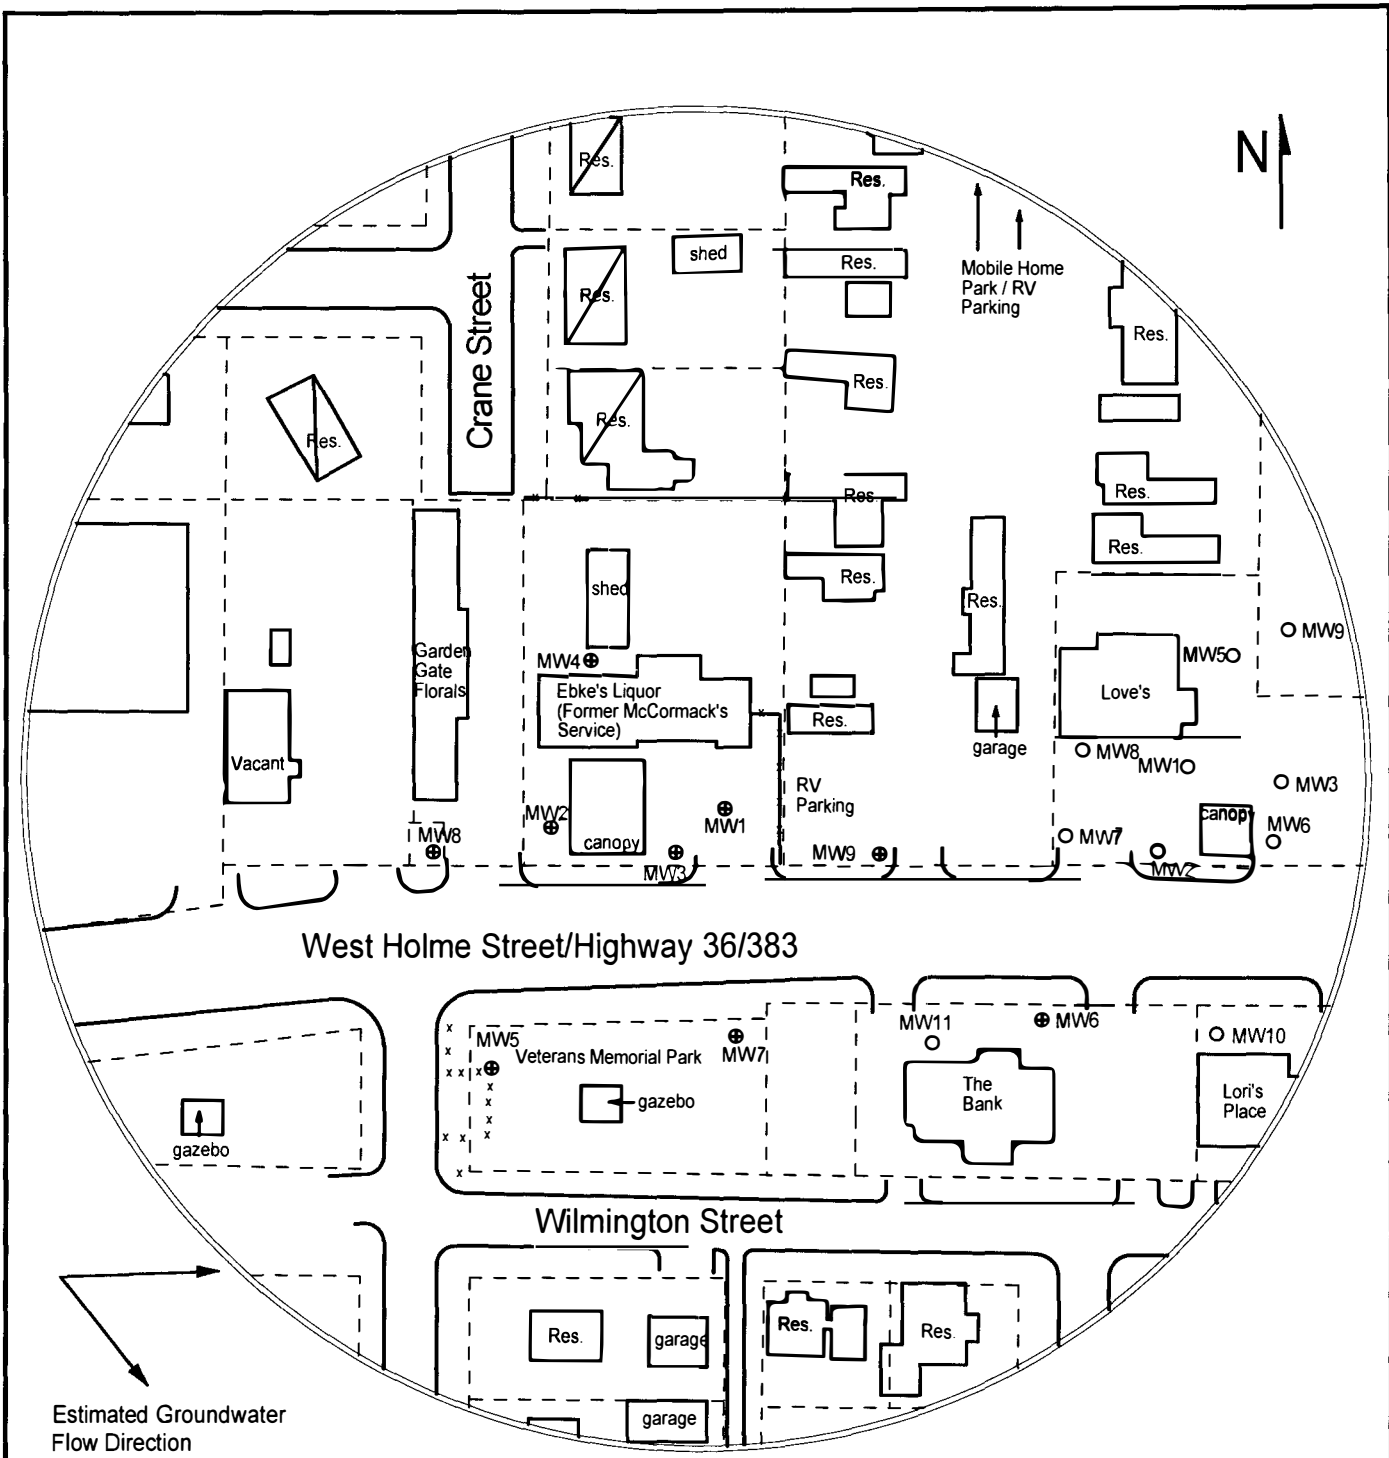

LEGEND:

- Approximate Location of Former UST Basin & Pump Island
- Approximate Location of Active UST Basin & Pump Island
- Building with Basement
- Approximate Location of Property Line
- Existing Monitoring Well
- New Monitoring Well (installed 5/17, 19, 20, 24-27/22)
- Plugged Monitoring Well (Love's Country Store 60)

PROJECT:

McCormack's Service
 407 W. Holme
 Norton, KS
 KDHE ID: U6-069-00154
 Date: 6/1/22



1311 E 25th St. Suite B 785-841-8707 office
 Lawrence, KS 66046 785-865-4282 fax

