


WATER WELL RECORD Form WWC-5 KSA 82a-1212

1 LOCATION OF WATER WELL: Fraction NW 1/4 NW 1/4 1/4 Section Number 21 Township Number T 2 S Range Number R 24 EW

Distance and direction from nearest town or city street address of well if located within city?
Six Miles West, three miles north, 3/4 mile west of Norton, Kansas

2 WATER WELL OWNER: Alfred Benien
RR#, St. Address, Box # : 406 N. 2nd
City, State, ZIP Code : Norton, KS 67654
Board of Agriculture, Division of Water Resources
Application Number:

3 LOCATE WELL'S LOCATION WITH AN "X" IN SECTION BOX:

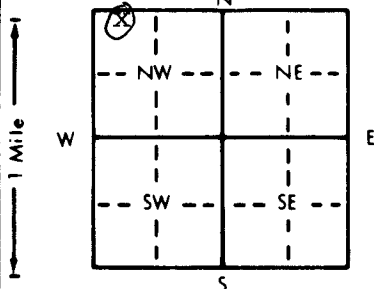

4 DEPTH OF COMPLETED WELL: 182 ft. ELEVATION:

Depth(s) Groundwater Encountered 1. 125 ft. 2. ft. 3. ft.
WELL'S STATIC WATER LEVEL 125 ft. below land surface measured on mo/day/yr 11/29/95
Pump test data: Well water was ft. after hours pumping gpm
Est. Yield 4.5 gpm. Well water was ft. after hours pumping gpm
Bore Hole Diameter 9 in. to 182 ft., and in. to ft.
WELL WATER TO BE USED AS:
 Domestic 3 Feedlot 6 Oil field water supply 9 Dewatering 12 Other (Specify below)
 2 Irrigation 4 Industrial 7 Lawn and garden only 10 Monitoring well
 Was a chemical/bacteriological sample submitted to Department? Yes No XX; If yes, mo/day/yr sample was submitted
 Water Well Disinfected? Yes XX No

5 TYPE OF BLANK CASING USED:
 1 Steel 3 RMP (SR) 5 Wrought iron 8 Concrete tile CASING JOINTS: Glued Clamped
 2 PVC 4 ABS 6 Asbestos-Cement 9 Other (specify below) Welded w/screws
 7 Fiberglass Threaded

Blank casing diameter 5 in. to 172 ft. Dia. in. to ft. Dia. in. to ft.
Casing height above land surface 0 in., weight 2.366 lbs./ft. Wall thickness or gauge No. 214

TYPE OF SCREEN OR PERFORATION MATERIAL:
 1 Steel 3 Stainless steel 5 Fiberglass 8 RMP (SR) 10 Asbestos-cement
 2 Brass 4 Galvanized steel 6 Concrete tile 9 ABS 11 Other (specify)
 12 None used (open hole)

SCREEN OR PERFORATION OPENINGS ARE:
 1 Continuous slot 3 Mill slot 5 Gauzed wrapped 8 Saw cut 11 None (open hole)
 2 Louvered shutter 4 Key punched 6 Wire wrapped 9 Drilled holes
 7 Torch cut 10 Other (specify)

SCREEN-PERFORATED INTERVALS: From 172 ft. to 182 ft. From ft. to ft.
 From ft. to ft. From ft. to ft.
 GRAVEL PACK INTERVALS: From 25 ft. to 182 ft. From ft. to ft.
 From ft. to ft. From ft. to ft.

6 GROUT MATERIAL: 1 Neat cement 2 Cement grout 3 Bentonite 4 Other
 Grout Intervals: From 5 ft. to 25 ft. From ft. to ft. From ft. to ft.

What is the nearest source of possible contamination:
 1 Septic tank 4 Lateral lines 7 Pit privy 10 Livestock pens 14 Abandoned water well
 2 Sewer lines 5 Cess pool 8 Sewage lagoon 11 Fuel storage 15 Oil well/Gas well
 3 Watertight sewer lines 6 Seepage pit 9 Feedyard 12 Fertilizer storage 16 Other (specify below)
 13 Insecticide storage

Direction from well? southeast How many feet? 15 (has been plugged)

FROM	TO	LITHOLOGIC LOG	FROM	TO	PLUGGING INTERVALS
0	15	Clay			
15	50	Fine sand/Clay			
50	52	Rock			
52	58	Brown Sandstone/Gravel			
58	78	Sand, Sandstone, Clay Mix			
78	82	Hard Sandstone			
82	115	Clay/Sandy Clay mix			
115	120	Sand/Sandstone			
120	135	Sandstone/Coarse Gravel			
135	182	Coarse Sand, Coarse gravel			
	182	Shale			

7 CONTRACTOR'S OR LANDOWNER'S CERTIFICATION: This water well was (1) constructed, (2) reconstructed, or (3) plugged under my jurisdiction and was completed on (mo/day/year) November 29, 1995 and this record is true to the best of my knowledge and belief. Kansas Water Well Contractor's License No. 386 This Water Well Record was completed on (mo/day/yr) December 19, 1995 under the business name of Ott Enterprises by (signature) Gloria K Hinrichs

INSTRUCTIONS: Use typewriter or ball point pen. PLEASE PRESS FIRMLY and PRINT clearly. Please fill in blanks, underline or circle the correct answers. Send top three copies to Kansas Department of Health and Environment, Bureau of Water, Topeka, Kansas 66620-0001. Telephone: 913-296-5545. Send one to WATER WELL OWNER and retain one for your records.