


1 LOCATION OF WATER WELL:	Fraction E 1/2 SE 1/4 SE 1/4	Section Number 33	Township Number 2	Range Number 24 W
---------------------------	-------------------------------------	--------------------------	--------------------------	--------------------------

Distance and direction from nearest town or city street address of well if located within city? _____

2 WATER WELL OWNER: **Lenora Braun**
 RR#, St. Address, Box # **Rt. 2 Box 51**
 City, State, ZIP Code: **Norton, KS 67654**
 Board of Agriculture, Division of Water Resources
 Application Number: _____

3 MARK WELL'S LOCATON WITH AN "X" IN SECTION BOX:

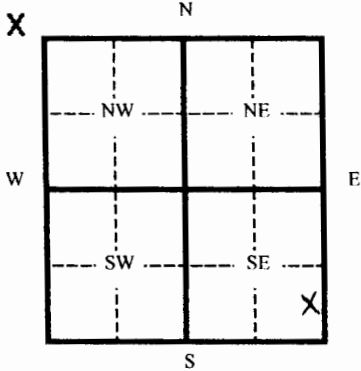

4 DEPTH OF WELL **10** ft.

WELL'S STATIC WATER LEVEL **dry** ft.

WELL WAS USED AS:

- | | | |
|---|------------------------------|--------------------|
| <input checked="" type="radio"/> 1 Domestic | 5 Public Water Supply | 9 Dewatering |
| 2 Irrigation | 6 Oil Field Water Supply | 10 Monitoring Well |
| 3 Feedlot | 7 Lawn and Garden (domestic) | 11 Injection Well |
| 4 Industrial | 8 Air Conditioning | 12 Other |

Was a chemical/bacteriological sample submitted to Department? Yes _____ No

If yes, mo/day/yr sample was submitted _____

Water Well Disinfected: Yes _____ No _____

5 TYPE OF BLANK CASING USED:

- | | | | | |
|---------|------------|-----------|--------------|-------------------------|
| 1 Steel | 3 RMP (SR) | 5 Wrought | 7 Fiberglass | 9 Other (specify below) |
|---------|------------|-----------|--------------|-------------------------|

- | | | | |
|---|-------|-------------------|-----------------|
| <input checked="" type="checkbox"/> 2 PVC | 4 ABC | 6 Asbestos-Cement | 8 Concrete Tile |
|---|-------|-------------------|-----------------|

Blank casing diameter **4** in. Was casing pulled? Yes _____ No If yes, how much _____

Casing height above or below land surface **0** in.

6 GROUT PLUG MATERIAL: 1 Neat cement 2 Cement grout 3 Bentonite 4 Other _____

Grout Plug Intervals From **10** ft. to **0** ft. From _____ ft. to _____ ft. From _____ ft. to _____ ft.

What is the nearest source of possible contamination:

- | | | | |
|--------------------------|-------------------|-------------------------|--------------------------|
| 1 Septic tank | 6 Seepage pit | 11 Fuel storage | 16 Other (specify below) |
| 2 Sewer lines | 7 Pit privy | 12 Fertilizer storage | |
| 3 Watertight sewer lines | 8 Sewage lagoon | 13 Insecticide storage | |
| 4 Lateral lines | 9 Feedyard | 14 Abandoned water well | |
| 5 Cess Pool | 10 Livestock pens | 15 Oil well/ Gas well | |

Direction from well? _____ How many feet? _____

FROM	TO	CODE	PLUGGING MATERIALS
10	0		Bentonite grout

7 CONTRACTOR'S OR LANDOWNER'S CERTIFICATION: This water well was plugged under my jurisdiction and was completed on (mo/day/yr) **2-15-06** and this record is true to the best of my knowledge and belief. Kansas Water Well Contractor's License No. **554** This Water Well Record was completed on (mo/day/yr) **3-3-06** under the business name of **Woofter Pump & Well Inc.** by (signature) *[Signature]*

INSTRUCTIONS: Please fill in blanks and circle the correct answers. Send three copies to Kansas Department of Health and Environment, Bureau of Water, 1000 S W Jackson St., Ste. 420, Topeka, Kansas 66620-0001. Telephone: 785-296-3565. Send one to Water Well Owner and retain one for your records.