


1 LOCATION OF WATER WELL: Fraction **NW ¼ SE ¼ NW ¼** Section Number **28** Township Number **T 2 S** Range Number **R 24** EW
 County: **Norton**

Distance and direction from nearest town or city street address of well if located within city?

2 WATER WELL OWNER: **Alfred Benies**
 RR#, St. Address, Box # : **406 N 2nd**
 City, State, ZIP Code : **Norton, Ks 67654**
 Board of Agriculture, Division of Water Resources
 Application Number: **20060380**

3 LOCATE WELL'S LOCATION WITH AN "X" IN SECTION BOX:

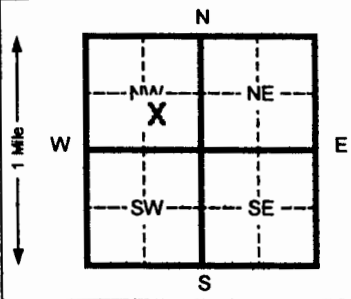

4 DEPTH OF COMPLETED WELL **130** ft. ELEVATION: _____
 Depth(s) Groundwater Encountered 1 _____ ft. 2 _____ ft. 3 _____ ft.
 WELL'S STATIC WATER LEVEL **na** ft. below land surface measured on mo/day/yr
 Pump test data: Well water was _____ ft. after _____ hours pumping _____ gpm
 Est. Yield _____ gpm: Well water was _____ ft. after _____ hours pumping _____ gpm
 Bore Hole Diameter **8** in. to **128** ft. and _____ in. to _____ ft.
 WELL WATER TO BE USED AS: Public water supply Air conditioning Injection well
 Domestic Feed lot Oil field water supply Dewatering Other (Specify below)
 Irrigation Industrial Lawn and garden (domestic) Monitoring well
 Was a chemical/bacteriological sample submitted to Department? Yes _____ No If yes, mo/day/yr sample was submitted _____
 Water Well Disinfected? Yes No _____

5 TYPE OF BLANK CASING USED: 1 Steel 2 PVC 3 RMP (SR) 4 ABS 5 Wrought Iron 6 Asbestos-Cement 7 Fiberglass 8 Concrete tile 9 Other (specify below)
 CASING JOINTS: Glued Clamped _____ Welded _____ Threaded _____
 Blank casing diameter **4.5** in. to **90** ft. Dia _____ in. to _____ ft. Dia _____ in. to _____ ft.
 Casing height above land surface **18** in., weight **2.38** lbs./ft. Wall thickness or gauge No. **248**

TYPE OF SCREEN OR PERFORATION MATERIAL: 1 Steel 2 Brass 3 Stainless steel 4 Galvanized steel 5 Fiberglass 6 Concrete tile 7 PVC 8 RMP (SR) 9 ABS 10 Asbestos-cement 11 Other (specify) 12 None used (open hole)
 SCREEN OR PERFORATION OPENINGS ARE: 1 Continuous slot 2 Louvered shutter 3 Mill slot 4 Key punched 5 Gauzed wrapped 6 Wire wrapped 7 Torch cut 8 Saw cut 9 Drilled holes 10 Other (specify) 11 None (open hole)

SCREEN-PERFORATED INTERVALS: From **90** ft. to **130** ft. From _____ ft. to _____ ft.
 From _____ ft. to _____ ft. From _____ ft. to _____ ft.
 GRAVEL PACK INTERVALS: From **20** ft. to **130** ft. From _____ ft. to _____ ft.
 From _____ ft. to _____ ft. From _____ ft. to _____ ft.

6 GROUT MATERIAL: 1 Neat cement 2 Cement grout 3 Bentonite 4 Other _____
 Grout intervals From **0** ft. to **20** ft. From _____ ft. to _____ ft. From _____ ft. to _____ ft.
 What is the nearest source of possible contamination: 1 Septic tank 2 Sewer lines 3 Watertight sewer lines 4 Lateral lines 5 Cess pool 6 Seepage pit 7 Pit privy 8 Sewage lagoon 9 Feedyard 10 Livestock pens 11 Fuel storage 12 Fertilizer storage 13 Insecticide storage 14 Abandoned water well 15 Oil well/ Gas well 16 Other (specify below) **none**

Direction from well? _____ How many feet? _____

| FROM | TO | CODE | LITHOLOGIC LOG | FROM | TO | PLUGGING INTERVALS |
|------|----|------|------------------------------|------|-----|----------------------------------|
| 0 | 2 | | Surface | | | Strks |
| 2 | 12 | | Loess | 91 | 101 | Clay |
| 12 | 21 | | Cemented sand | 101 | 108 | Sandstone w/clay strks |
| 21 | 30 | | Clay | 108 | 128 | Clay & caliche w/sandstone strks |
| 30 | 35 | | Clay & fine sand | 128 | | Yellow ochre w/flint strks |
| 35 | 48 | | Sandstone | | | |
| 48 | 51 | | Soft sandstone w/sand strks | | | |
| 51 | 56 | | Fine sand w/sandstone strks | | | |
| 56 | 62 | | Sandstone | | | |
| 62 | 67 | | Fine to some med sand | | | |
| 67 | 70 | | Clay & caliche | | | |
| 70 | 75 | | Fine to med sand | | | |
| 75 | 82 | | Clay | | | |
| 82 | 91 | | Fine to some med sand w/clay | | | |

7 CONTRACTOR'S OR LANDOWNER'S CERTIFICATION: This water well was (1) constructed, (2) reconstructed, or (3) plugged under my jurisdiction and was completed on (mo/day/yr) **10-17-06** and this record is true to the best of my knowledge and belief. Kansas Water Well Contractor's License No. **554** This Water Well Record was completed on (mo/day/yr) **10-20-06** under the business name of **Woofter Pump & Well Inc.** by (signature) *Jan C. Woofter*