

USE TYPEWRITER OR BALL POINT PEN-PRESS FIRMLY, PRINT CLEARLY.

WATER WELL RECORD
KSA 82a-1201-1215


Kansas Department of Health and Environment-Division of Environment (Water well Contractors) Topeka, Kansas 66620

BBB

Survey

1. Location of well: County Norton Fraction N¹/₄ N¹/₄ N¹/₄ Section number 17 Township number T 2 S R 24W E/W Range number

2. Distance and direction from nearest town or city: 9 west 4 North of Norton Kansas 67525
Street address of well location if in city:
3. Owner of well: Clarence Kintigh
R.R. or street:
City, state, zip code: Norton Kansas 67654

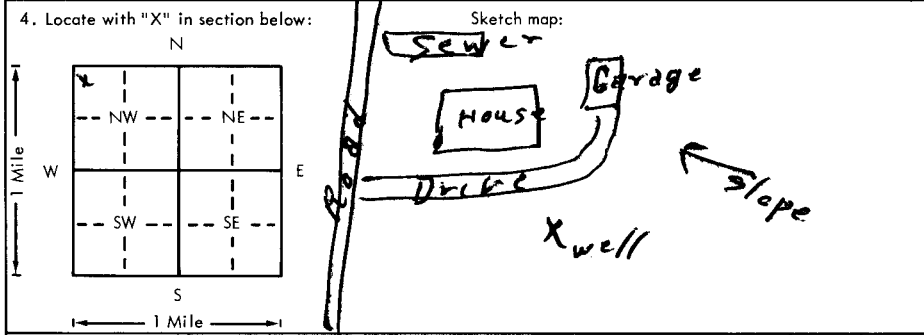

6. Bore hole dia. 9 in. Completion date 10/16/79
Well depth 215 ft.
7. Cable tool Rotary Driven Dug
 Hollow rod Jetted Bored Reverse rotary
8. Use: Domestic Public supply Industry
 Irrigation Air conditioning Stock
 Lawn Oil field water Other
9. Casing: Material P/S Height: Above or below
Threaded Welded Surface 12 in.
RMP PVC Weight 275 lbs./ft.
Dia. 5 in. to 195 ft. depth Wall Thickness: inches or
Dia. 5 in. to 195 ft. depth gauge No. 254

5. Type and color of material	From	To
<u>clay</u>	<u>0</u>	<u>30</u>
<u>Lime Rock + sand</u>	<u>30</u>	<u>167</u>
<u>Brown clay</u>	<u>167</u>	<u>192</u>
<u>lime Rock + Fine sand</u>	<u>192</u>	<u>203</u>
<u>sand (medium)</u>	<u>203</u>	<u>215</u>
<u>BROCK ?</u>		
<u>215 (sat)</u>		
<u>191 ft</u>		
<u>24' sat thick</u>		
<u>in Og</u>		

10. Screen: Manufacturer's name Modern Pipe Inc
Type PVC Dia. 5
Slot/gauze slot Length 20
Set between 195 ft. and 215 ft.
ft. and 215 ft.
Gravel pack? yes Size range of material 1/4 x 1/4
11. Static water level: 191 ft. below land surface Date 9/13/79 mo./day/yr.
12. Pumping level below land surfaces:
191 ft. after 4 hrs. pumping 15 g.p.m.
191 ft. after 4 hrs. pumping 15 g.p.m.
Estimated maximum yield 15 g.p.m.
13. Water sample submitted: yes Yes No Date
14. Well head completion: Pitless adapter 12 inches above grade
15. Well grouted? yes
With: Neat cement Bentonite Concrete
Depth: From 4 ft. to 16 ft.
16. Nearest source of possible contamination: North sewer
ft. 280' Direction North sewer
Well disinfected upon completion? Yes No
17. Pump: Not installed
Manufacturer's name Aeroboy
Model number SD12-75 HP 3/4 Vol 230
Length of drop pipe 205 ft. capacity 12 g.p.m.
Type: Submersible Turbine
 Jet Reciprocating
 Centrifugal Other

18. Elevation: 2565
19. Remarks: Please send well log forms
Topography: Hill Slope Upland Valley

20. Water well contractor's certification:
This well was drilled under my jurisdiction and this report is true to the best of my knowledge and belief.
Fawcettson Drilling 167
Business name Norton Kansas License No.
Address Norton Kansas
Signed John R. Fawcett Date 11/8/79
Authorized representative

T 24 E 17 NW 1/4 1/4 1/4