


1 LOCATION OF WATER WELL: County: **Norton** Fraction: **SE 1/4 SE 1/4 SE 1/4** Section Number: **19** Township Number: **T 2 S** Range Number: **R 24 EW**

Distance and direction from nearest town or city street address of well if located within city? **From junction 36+283 9 mi. West 2 N.**

2 WATER WELL OWNER: **Donna Hale**
 RR#, St. Address, Box #: **Rt. 2 Box 46**
 City, State, ZIP Code: **Norton, Kansas 67654**
 Board of Agriculture, Division of Water Resources
 Application Number:

3 LOCATE WELL'S LOCATION WITH AN "X" IN SECTION BOX: **N**
W **E**
S

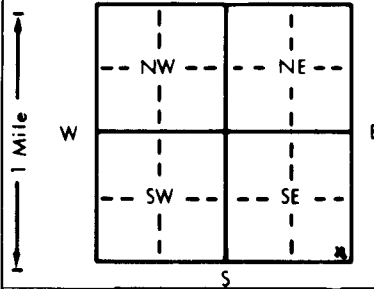

4 DEPTH OF COMPLETED WELL: **160** ft. ELEVATION:
 Depth(s) Groundwater Encountered 1. ft. 2. ft. 3. ft.
 WELL'S STATIC WATER LEVEL: **107** ft. below land surface measured on mo/day/yr
 Pump test data: Well water was ft. after hours pumping gpm
 Est. Yield gpm: Well water was ft. after hours pumping gpm
 Bore Hole Diameter: **9** in. to **25** ft., and **8** in. to **160** ft.
 WELL WATER TO BE USED AS:
 1 Domestic 3 Feedlot 6 Oil field water supply 9 Dewatering 12 Other (Specify below)
 2 Irrigation 4 Industrial 7 Lawn and garden only 10 Monitoring well
 Was a chemical/bacteriological sample submitted to Department? Yes.....No. If yes, mo/day/yr sample was submitted
 Water Well Disinfected? Yes No

5 TYPE OF BLANK CASING USED:
 1 Steel 3 RMP (SR) 5 Wrought iron 8 Concrete tile CASING JOINTS: Glued Clamped
 2 PVC 4 ABS 6 Asbestos-Cement 9 Other (specify below) Welded
 7 Fiberglass Threaded
 Blank casing diameter: **5** in. to **140** ft., Dia. in. to ft., Dia. in. to ft.
 Casing height above land surface: **12** in., weight lbs./ft. Wall thickness or gauge No. **SDR 21**

TYPE OF SCREEN OR PERFORATION MATERIAL:
 1 Steel 3 Stainless steel 5 Fiberglass 7 PVC 10 Asbestos-cement
 2 Brass 4 Galvanized steel 6 Concrete tile 8 RMP (SR) 11 Other (specify)
 9 ABS 12 None used (open hole)

SCREEN OR PERFORATION OPENINGS ARE:
 1 Continuous slot 3 Mill slot 5 Gauzed wrapped 8 Saw cut 11 None (open hole)
 2 Louvered shutter 4 Key punched 6 Wire wrapped 9 Drilled holes
 7 Torch cut 10 Other (specify)

SCREEN-PERFORATED INTERVALS: From **140** ft. to **160** ft., From ft. to ft.
 From ft. to ft., From ft. to ft.
 GRAVEL PACK INTERVALS: From **25** ft. to **160** ft., From ft. to ft.
 From ft. to ft., From ft. to ft.

6 GROUT MATERIAL: 1 Neat cement 2 Cement grout 3 Bentonite 4 Other
 Grout Intervals: From **5** ft. to **25** ft., From ft. to ft., From ft. to ft.

What is the nearest source of possible contamination:
 1 Septic tank 4 Lateral lines 7 Pit privy 10 Livestock pens 14 Abandoned water well
 2 Sewer lines 5 Cess pool 8 Sewage lagoon 11 Fuel storage 15 Oil well/Gas well
 3 Watertight sewer lines 6 Seepage pit 9 Feedyard 12 Fertilizer storage 16 Other (specify below)
 13 Insecticide storage

Direction from well? **SW** How many feet? **200**

FROM	TO	LITHOLOGIC LOG	FROM	TO	PLUGGING INTERVALS
0	28	Top Soil & Clay			
28	100	Clay, Sandstone, fine sand			
100	127	Fine Sand			
127	157	Better sand to gravel			
157	160	Sandstone, fine sand & clay			
160	200	Clay			

7 CONTRACTOR'S OR LANDOWNER'S CERTIFICATION: This water well was (1) constructed, (2) reconstructed, or (3) plugged under my jurisdiction and was completed on (mo/day/year) **10-21-92** and this record is true to the best of my knowledge and belief. Kansas Water Well Contractor's License No. **428** This Water Well Record was completed on (mo/day/yr) **10-29-92** under the business name of **STALDER DRILLING** by (signature) **Jerry L Stalder**