USE TYPEWRITER OR BALL POINT PEN-PRESS FIRMLY, PRINT CLEARLY.

NWNW

WATER WELL RECORD
KSA 82a-1201-1215

BBA

Kansas Department of Health and Environment-Division of Environment
(Water well Contractors)
Topeka, Kansas 66620

1. Location of well:	County	Fraction	Section number	Township number	Range number
	Norton	X NE 1/4 NW 1/4 NW 1/4	27	T 2 S	R 24 (W)

2. Distance and direction from nearest town or city: Seven miles west & 2 miles north of Norton.
Street address of well location if in city:

3. Owner of well: Harold Holste.
R.R. or street: RR#2
City, state, zip code: Norton, Ks 67654

4. Locate with "X" in section below:

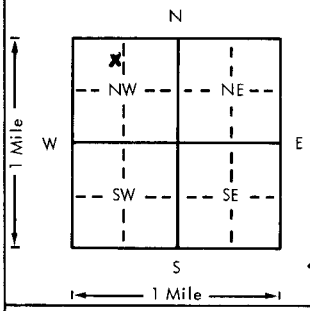

Sketch map:

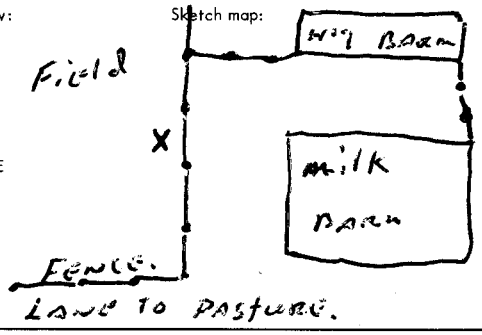

6. Bore hole dia. 9 in. Completion date
Well depth 145 ft. 5-9-78

7. __ Cable tool X Rotary __ Driven __ Dug
__ Hollow rod __ Jetted __ Bored __ Reverse rotary

8. Use: __ Domestic __ Public supply __ Industry
__ Irrigation __ Air conditioning X Stock
__ Lawn __ Oil field water __ Other

9. Casing: Material _____ Height: Above ~~or below~~
Threaded ____ Welded ____ Surface 12 in.
RMP ____ PVC X Weight 275 lbs./ft.
Dia. 5 in. to 125 ft. depth Wall Thickness: inches or
Dia. ____ in. to ____ ft. depth gage No. 258

5. Type and color of material	From	To
Clay Tan	0	34
Clay white	34	44
Clay white Sandy.	44	57
Sandstone & White Rock.	57	145
BROCK ?		
(Use a second sheet if needed)		

10. Screen: Manufacturer's name Modern Pipes Inc
Type PVC Dia. 5
Slot/~~Gauze~~ 030 Length 20'
Set between 125 ft. and 145 ft.
____ ft. and ____ ft.
Gravel pack? YES Size range of material

11. Static water level: mo./day/yr.
120 ft. below land surface Date 5-31-78

12. Pumping level below land surfaces:
____ ft. after ____ hrs. pumping ____ g.p.m.
____ ft. after ____ hrs. pumping ____ g.p.m.
Estimated maximum yield 25 g.p.m.

13. Water sample submitted: mo./day/yr.
__ Yes X No Date

14. Well head completion:
X Pitless adapter 12 Inches above grade

15. Well grouted? YES
With: __ Neat cement __ Bentonite X Concrete
Depth: From 5 ft. to 15 ft.

16. Nearest source of possible contamination: Cow lot.
ft. 100 Direction East Type
Well disinfected upon completion? X Yes __ No

17. Pump: __ Not installed
Manufacturer's name Aermotor
Model number SD 12 HP 3/4 Volts 230
Length of drop pipe 132 ft. capacity 12 g.p.m.
Type:
X Submersible __ Turbine
__ Jet __ Reciprocating
__ Centrifugal __ Other

18. Elevation:
Topography:
__ Hill
__ Slope
X Upland
__ Valley

19. Remarks: 2470

20. Water well contractor's certification:
This well was drilled under my jurisdiction and this report is true to the best of my knowledge and belief.
Fawcett Drilling 167
Business name License No.
Address Box 149 Norton Ks
Signed [signature] Date 8-25-78
Authorized representative

T 2 S R 24 (W) Sec 27 1/4 1/4 1/4 1/4 NWNW

Forward the white, blue and pink copies to the Department of Health and Environment

Form WWC-5