USE TYPEWRITER OR BALL POINT PEN-PRESS FIRMLY, PRINT CLEARLY.

WATER WELL RECORD
KSA 82a-1201-1215

Kansas Department of Health and Environment-Division of Environment
(Water well Contractors)
Topeka, Kansas 66620

1. Location of well:	County	Fraction	Section number	Township number	Range number
	Norton	SE 1/4 SW 1/4 SE 1/4	36	T 2 S	R 24W E/W

2. Distance and direction from nearest town or city:
4 Miles west of Norton
Street address of well location if in city:

3. Owner of well: Lanny Kampe
R.R. or street: Rt.3 Norton, Kansas 67654
City, state, zip code:

4. Locate with "X" in section below:

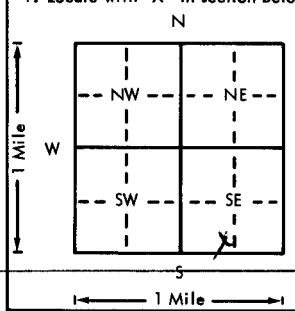

Sketch map:

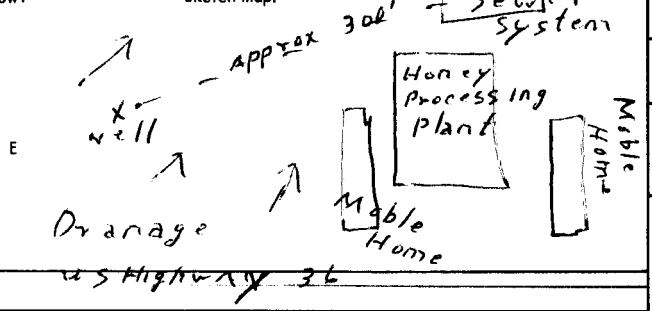

6. Bore hole dia. 9 in. Completion date 11/10/75
Well depth 120 ft.

7. __ Cable tool X Rotary __ Driven __ Dug
__ Hollow rod __ Jetted __ Bored __ Reverse rotary

8. Use: X Domestic __ Public supply X Industry
__ Irrigation __ Air conditioning __ Stock
__ Lawn __ Oil field water __ Other

9. Casing: Material RMP
Threaded ___ Welded Gl
RMP X PVC ___
Dia. 5 in. to 120 ft. depth
Dia. ___ in. to ___ ft. depth
Height: Above or below Surface 12 in.
Weight 180 lbs./ft.
Wall Thickness: inches or gage No. 250

5. Type and color of material	From	To
Clay & Top soil	0	50
Sandy clay, yellow	50	71
Lime rock & sand ' white)	71	82
Green clay	82	100
Fine sand & lime rock	100	120
?		
(Use a second sheet if needed)		

10. Screen: Manufacturer's name Modern Pipe Inc.
Type PVC Dia. 5
Slot/gauze Slot Length 20'
Set between 100 ft. and 120 ft.
___ ft. and ___ ft.
Gravel pack? yes Size range of material 1/4 - 1/8

11. Static water level: mo./day/yr.
80 ft. below land surface Date 11/10/75

12. Pumping level below land surfaces:
___ ft. after ___ hrs. pumping ___ g.p.m.
___ ft. after ___ hrs. pumping ___ g.p.m.
Estimated maximum yield 30 g.p.m.

13. Water sample submitted: mo./day/yr.
___ Yes X No Date ___

14. Well head completion:
X Pitless adapter 12 Inches above grade

15. Well grouted? Yes
With: X Neat cement ___ Bentonite ___ Concrete
Depth: From 5 ft. to 15 ft.

16. Nearest source of possible contamination:
ft. 300 Direction NE Type Sewer
Well disinfected upon completion? X Yes ___ No

17. Pump: ___ Not installed
Manufacturer's name Aermotor
Model number SD 12-75 HP 3/4 Volts 230
Length of drop pipe 105 ft. capacity 12 g.p.m.
Type:
X Submersible ___ Turbine
___ Jet ___ Reciprocating
___ Centrifugal ___ Other

T 2 R 24 (W) E Sec 36 1/4 SE 1/4 SW 1/4 SE

18. Elevation:
Topography:
___ Hill
___ Slope
X Upland
___ Valley

19. Remarks: 2403 (TOPO)

20. Water well contractor's certification:
This well was drilled under my jurisdiction and this report is true to the best of my knowledge and belief.
John R. Fawcett & Son 167
Business name License No.
Address Box 149 Norton, Kansas
Signed John R. Fawcett Date 11/21/75
Authorized representative

Forward the white, blue and pink copies to the Department of Health and Environment

Form WWC-5