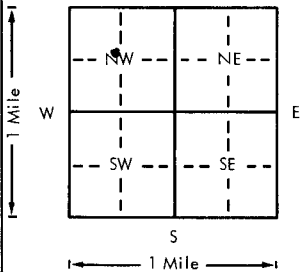


USE TYPEWRITER OR BALL POINT PEN-PRESS FIRMLY, PRINT CLEARLY.

WATER WELL RECORD
KSA 82a-1201-1215

Kansas Department of Health and Environment-Division of Environment (Water well Contractors) Topeka, Kansas 66620

BBD

1. Location of well:	County <u>Norton</u>	Fraction <u>SE 1/4 NW 1/4 NW 1/4</u>	Section number <u>25</u>	Township number T <u>2</u> S	Range number R <u>25</u> E <u>(W)</u>
2. Distance and direction from nearest town or city: Street address of well location if in city: <u>1 3/4 North-1/4 East from Reager</u>			3. Owner of well: <u>Irvin Bokis</u> R.R. or street City, state, zip code: <u>Norton, Kans. 67454</u>		
4. Locate with "X" in section below: Sketch map: 			6. Bore hole dia. <u>20</u> in. Completion date <u>8/20/79</u> Well depth <u>130</u> ft.		
			7. <input type="checkbox"/> Cable tool <input type="checkbox"/> Rotary <input type="checkbox"/> Driven <input type="checkbox"/> Dug <input type="checkbox"/> Hollow rod <input type="checkbox"/> Jetted <input type="checkbox"/> Bored <input checked="" type="checkbox"/> Reverse rotary		
			8. Use: <input type="checkbox"/> Domestic <input type="checkbox"/> Public supply <input type="checkbox"/> Industry <input checked="" type="checkbox"/> Irrigation <input type="checkbox"/> Air conditioning <input type="checkbox"/> Stock <input type="checkbox"/> Lawn <input type="checkbox"/> Oil field water <input type="checkbox"/> Other		
			9. Casing: Material <u>Steel</u> Height: Above or below Threaded <input type="checkbox"/> Welded <input checked="" type="checkbox"/> Surface <u>12</u> in. RMP <input type="checkbox"/> PVC <input type="checkbox"/> Weight <input type="checkbox"/> lbs./ft. Dia. <u>1 3/4</u> in. to <u>130</u> ft. depth Wall Thickness: inches or Dia. <input type="checkbox"/> in. to <input type="checkbox"/> ft. depth gage No. <u>188</u>		
5. Type and color of material			From	To	10. Screen: Manufacturer's name <u>W.F. Brown</u>
<u>Top Soil</u>			<u>1</u>	<u>00</u>	Type <u>boxer</u> Dia. <u>12 3/4</u>
<u>60-130 gravel & sand stone</u>			<u>60</u>	<u>130</u>	Slot/gauze <u>188-1/4</u> Length <u>30'</u>
					Set between <u>Bottom</u> ft. and <u>100</u> ft.
					Gravel pack? <u>Yes</u> Size range of material <u>1/4-3/8</u>
					11. Static water level: mo./day/yr. <u>77</u> ft. below land surface Date <u>8/20/79</u>
					12. Pumping level below land surfaces: <u>130</u> ft. after <u>5</u> hrs. pumping <u>750</u> g.p.m. Estimated maximum yield <u>750</u> g.p.m.
					13. Water sample submitted: mo./day/yr. <input type="checkbox"/> Yes <input checked="" type="checkbox"/> No Date
					14. Well head completion: <input type="checkbox"/> Pitless adapter <u>12</u> Inches above grade
					15. Well grouted? <u>Yes</u> With: <input type="checkbox"/> Neat cement <input checked="" type="checkbox"/> Bentonite <input checked="" type="checkbox"/> Concrete Depth: From <u>10</u> ft. to <u>Top</u> ft.
					16. Nearest source of possible contamination: <u>None</u> ft. _____ Direction _____ Type _____ Well disinfected upon completion? <input type="checkbox"/> Yes <input type="checkbox"/> No
					17. Pump: Not installed Manufacturer's name <u>Boulde</u> Model number _____ HP _____ Volts _____ Length of drop pipe <u>120</u> ft. capacity <u>600</u> g.p.m. Type: <input type="checkbox"/> Submersible <input checked="" type="checkbox"/> Turbine <input type="checkbox"/> Jet <input type="checkbox"/> Reciprocating <input type="checkbox"/> Centrifugal <input type="checkbox"/> Other
(Use a second sheet if needed)					
18. Elevation: Topography: <input type="checkbox"/> Hill <input type="checkbox"/> Slope <input checked="" type="checkbox"/> Upland <input type="checkbox"/> Valley	19. Remarks: <u>2470</u>		20. Water well contractor's certification: This well was drilled under my jurisdiction and this report is true to the best of my knowledge and belief. <u>Blue Jay Drilling Co Inc</u> Business name License No. _____ Address <u>Box 503 Colby, Ks</u> Signed <u>Dale Hall</u> Date <u>8/20/79</u> Authorized representative		

T 2
R 25
W 25
S 25
E 25
N 25
1/4 1/4 1/4 1/4