

## WATER WELL PLUGGING RECORD

FORM WWC-5P

KSA 82a-1212

1 LOCATION OF WATER WELL:	Fraction	Section Number	Township Number	Range Number
County: <b>Decatur</b>	<b>NE 1/4 SW 1/4 NE 1/4</b>	<b>5</b>	<b>2</b>	<b>26W</b>

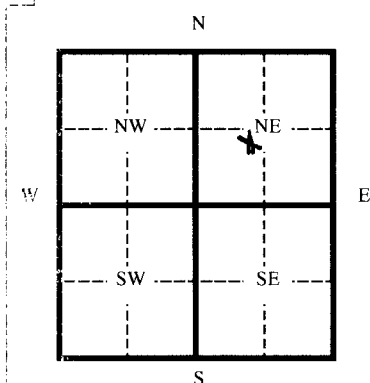
Distance and direction from nearest town or city street address of well if located within city?

2 WATER WELL OWNER: **Long Branch Farms, Inc.—David Stapp, Pres.**RR#, St. Address, Box # **2013 2700 Road**

Board of Agriculture, Division of Water Resources

City, State, ZIP Code : **ANorcat, KS 67653**Application Number: **20090297**

3 MARK WELL'S LOCATION WITH AN "X" IN SECTION BOX:

4 DEPTH OF WELL **180** ft.WELL'S STATIC WATER LEVEL **140** ft.

WELL WAS USED AS:

- |              |  |                    |
|--------------|--|--------------------|
| 1 Domestic   | 5 Public Water Supply  | 9 Dewatering       |
| 2 Irrigation | <input checked="" type="checkbox"/> 6 Oil Field Water Supply | 10 Monitoring Well |
| 3 Feedlot    | 7 Lawn and Garden (domestic)                                 | 11 Injection Well  |
| 4 Industrial | 8  | 12 Other           |

Was a chemical/bacteriological sample submitted to Department? Yes \_\_\_ No **X**

If yes, mo/day/yr sample was submitted \_\_\_\_\_

Water Well Disinfected: Yes **X** No \_\_\_

5 TYPE OF BLANK CASING USED:

1 Steel 3 RMP (SR) 5 Wrought 7 Fiberglass 9 Other (specify below)

☒ 2 PVC 4 ABC 6 Asbestos-Cement 8 Concrete TileBlank casing diameter **4.5** in. Was casing pulled? Yes \_\_\_ No **X** If yes, how much \_\_\_\_\_Casing height above or below land surface **-36** in.6 GROUT PLUG MATERIAL: 1 Neat cement 2 Cement grout 3 Bentonite 4 Other \_\_\_\_\_Grout Plug Intervals From **3** ft. to **6** ft. From **137** ft. to **140** ft. From \_\_\_\_\_ ft. to \_\_\_\_\_ ft.

What is the nearest source of possible contamination:

- |                          |                   |                         |                          |
|--------------------------|-------------------|-------------------------|--------------------------|
| 1 Septic tank            | 6 Seepage pit     | 11 Fuel storage         | 16 Other (specify below) |
| 2 Sewer lines            | 7 Pit privy       | 12 Fertilizer storage   |                          |
| 3 Watertight sewer lines | 8 Sewage lagoon   | 13 Insecticide storage  |                          |
| 4 Lateral lines          | 9 Feedyard        | 14 Abandoned water well |                          |
| 5 Cess Pool              | 10 Livestock pens | 15 Oil well/ Gas well   |                          |

Direction from well? \_\_\_\_\_

How many feet? \_\_\_\_\_

FROM	TO	CODE	PLUGGING MATERIALS
<b>180</b>	<b>140</b>		<b>Chlorinated sand</b>
<b>140</b>	<b>137</b>		<b>Bentonite</b>
<b>137</b>	<b>6</b>		<b>Clay</b>
<b>6</b>	<b>3</b>		<b>Bentonite</b>
<b>3</b>	<b>0</b>		<b>Native soil</b>

7 CONTRACTOR'S OR LANDOWNER'S CERTIFICATION: This water well was plugged under my jurisdiction and was completed on (mo/day/yr) **11/03/09** and this record is true to the best of my knowledge and belief. Kansas Water Well Contractor's License No. **554/783** This Water Well Record was completed on (mo/day/yr) **11/10/09** under the business name of **Woofter Pump & Well Inc.** by (signature) *[Signature]*

INSTRUCTIONS: Please fill in blanks and circle the correct answers. Send three copies to Kansas Department of Health and Environment, Bureau of Water, Topeka, Kansas 66620-0001. Telephone: 785-296-3565. Send one to Water Well Owner and retain one for your records.