

MW-1


Check: ☐ White Copy, ☐ Blue Copy, ☐ Pink Copy

JOB NO. 2015-245
 PROJECT Oberlin KS


LOG OF TEST BORING

VERTICAL SCALE 1" =

BORING NO. MW 1 - (East)

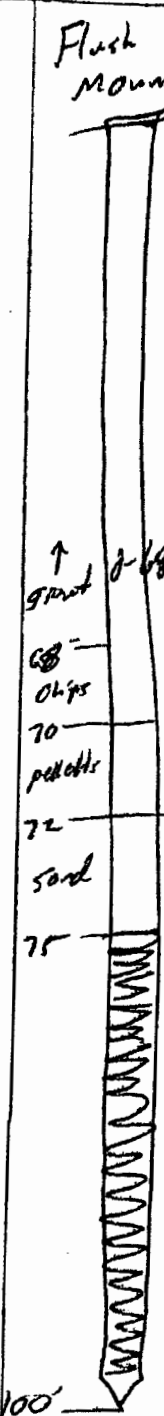DEPTH IN FEET	DESCRIPTION OF MATERIAL	GEOLOGIC ORIGIN	N	WL	SAMPLE		LABORATORY TESTS			
					NO.	TYPE	W	D	LL P.L.	QU
	<p>↑ SURFACE ELEVATION _____</p> <p>sandy silt - brown, moist ↓ w/ clay @ 25'</p> <p>↓ clay</p> <p>Near Black Shale = 80' - Hard - ↓</p> <p>Well Set @ 100' 25' screen @ 100' 12-20 sand to 72'</p>	<p>Flush mount Manhole -</p>  <p>grout @ 68'</p> <p>68' chips</p> <p>70 pebbles</p> <p>72 sand</p> <p>75</p> <p>100'</p>								

WATER LEVEL MEASUREMENTS							START _____ COMPLETE _____	
DATE	TIME	SAMPLED DEPTH	CASING DEPTH	CAVE-IN DEPTH	BAILED DEPTHS	WATER LEVEL	METHOD <u>4 1/2" HSA</u>	
					10		1-26-16 - - Tues	
					10			
					10			
					10		CREW CHIEF <u>DAI CH / SR</u>	

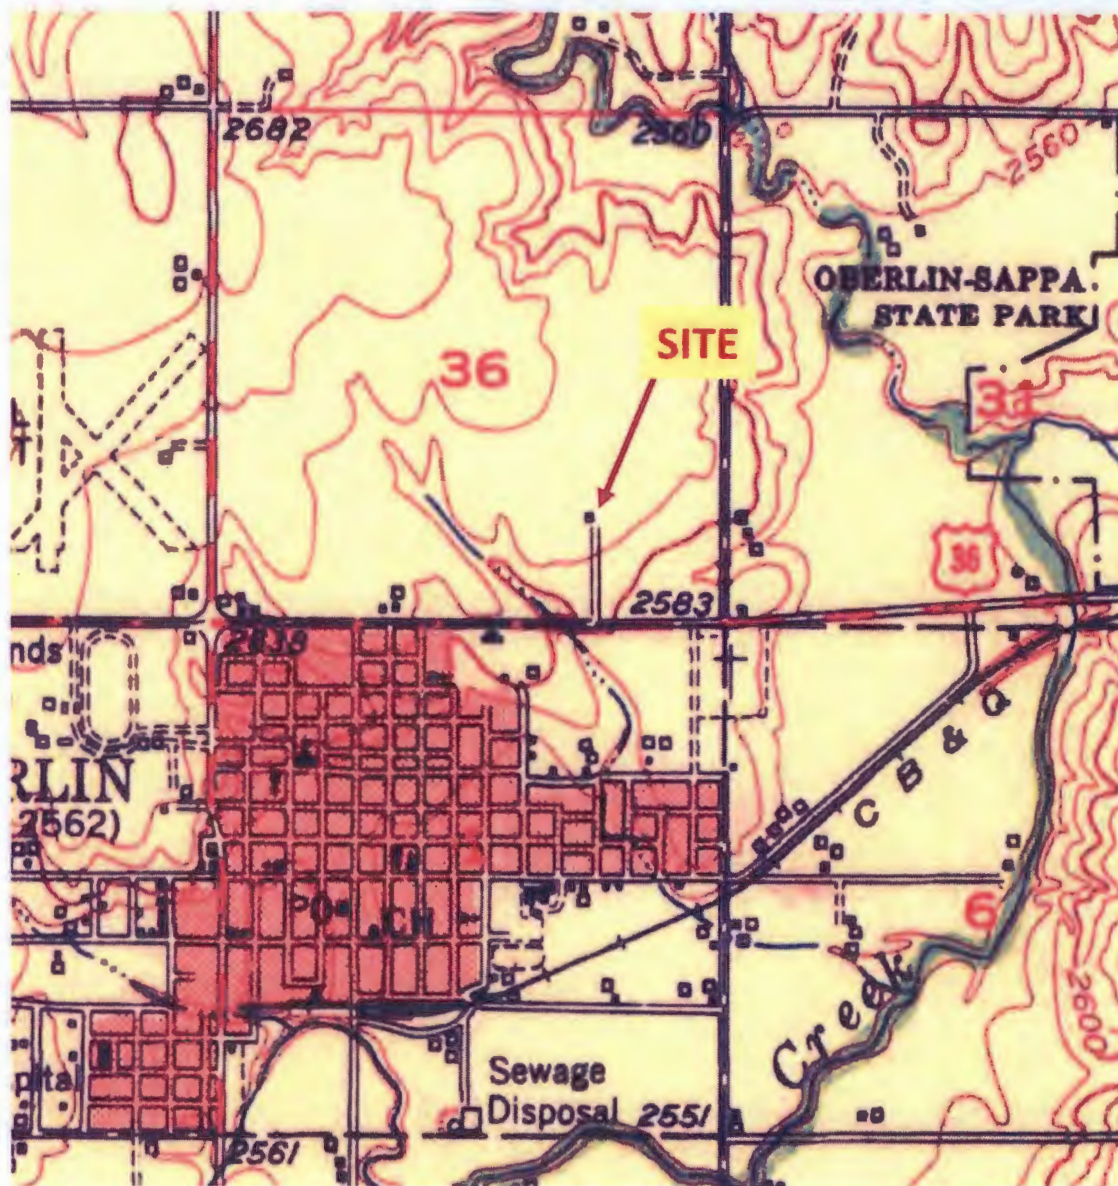

Mapped, edited, and published by the Geological Survey
as part of the Department of the Interior program
for the development of the Missouri River Basin

Control by USGS and USC&GS

Topography from aerial photographs by multiplex methods
and by plane-table surveys 1951. Aerial photographs taken 1950

OBERLIN, KANS.

N3945—W10030/15

1951

WCEC
ENVIRONMENTAL CONSULTANTS

West Central
Environmental Consultants
10504 Bluejacket Street
Overland Park, KS 66214

PROJECT NO: 15-10580-190

DESIGNED BY: WCEC

SCALE: NTS

REVIEWED BY: ESC

DRAWN BY: ESC

DATE: 9/11/15

FILE: FIG 1

FIGURE 1 – SITE LOCATION

KDHE VCPRP 15VCP0010

FORMER HANSEN-MUELLER PROPERTY
708 EAST FRONTIER STREET
OBERLIN, KANSAS

Survey 2/8/16 MT

