


| | | | | | | | | |
|---|-------------------------|-----------------------|----------|--------|----------|--------|-----------|-----------|
| 1 | LOCATION OF WATER WELL: | Fraction | Section | Number | Township | Number | Range | Number |
| | County: <u>Rawlins</u> | <u>SE ¼ NE ¼ NW ¼</u> | <u>3</u> | | <u>2</u> | | <u>31</u> | <u>EW</u> |

Distance and direction from nearest town or city street address of well if located within city?
105 Sunfield, Herndon

| | | |
|---|--|--|
| 2 | WATER WELL OWNER: <u>Decatur Coop Association</u> <u>PO Box 68</u> RR #, St. Address, Box #: <u>Overland Park, KS 67747</u> City, State, ZIP Code : | Board of Agriculture, Division of Water Resources Application Number: |
|---|--|--|

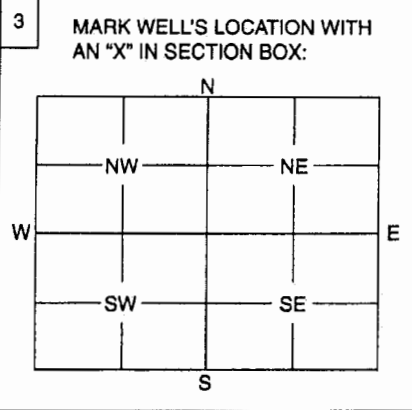

4 DEPTH OF WELL 31 ft.

WELL'S STATIC WATER LEVEL 20.5 ft.

WELL WAS USED AS:

| | | |
|--------------|----------------------------|---|
| 1 Domestic | 5 Public Water Supply | 9 Dewatering |
| 2 Irrigation | 6 Oil Field Water Supply | 10 Monitoring Well |
| 3 Feedlot | 7 Domestic (Lawn & Garden) | 11 Injection Well |
| 4 Industrial | 8 Air Conditioning | <input checked="" type="checkbox"/> Other <u>Air sparge</u> |

Was a chemical / bacteriological sample submitted to Department? Yes No

If yes, mo/day/yr sample was submitted

Water Well Disinfected: Yes No

5 TYPE OF BLANK CASING USED:

| | | | | |
|---|------------|-------------------|-----------------|-------------------------|
| 1 Steel | 3 RMP (SR) | 5 Wrought | 7 Fiberglass | 9 Other (Specify below) |
| <input checked="" type="checkbox"/> PVC | 4 ABS | 6 Asbestos-Cement | 8 Concrete Tile | |

Blank casing diameter 2 in. Was casing pulled? Yes No If yes, how much *

Casing height above or below land surface 0 in.

6 GROUT PLUG MATERIAL: 1 Neat cement 2 Cement grout Bentonite Other Native soil

Grout Plug Intervals: From 0 ft. to 1 ft., From 1 ft. to 31 ft., From to ft.

What is the nearest source of possible contamination:

| | | | |
|--------------------------|-------------------|-------------------------|--------------------------|
| 1 Septic tank | 6 Seepage pit | 11 Fuel storage | 16 Other (specify below) |
| 2 Sewer lines | 7 Pit privy | 12 Fertilizer storage | |
| 3 Watertight sewer lines | 8 Sewage lagoon | 13 Insecticide storage | |
| 4 Lateral lines | 9 Feedyard | 14 Abandoned water well | |
| 5 Cess pool | 10 Livestock pens | 15 Oil well/Gas well | |

Direction from well? How many feet?

| FROM | TO | PLUGGING MATERIALS |
|------|----|--------------------|
| 0 | 1 | Native soil |
| 1 | 3 | Bentonite (8") |
| 3 | 31 | Bentonite (2") |
| | | |
| | | |
| | | |
| | | |

*Drilled out to 3'

AS1

GeoCore #1103

7 CONTRACTOR'S OF LANDOWNER'S CERTIFICATION: This water well was plugged under my jurisdiction and was completed on (mo/day/year) 7/25/2006 and this record is true to the best of my knowledge and belief. Kansas Water Well Contractor's License No. 527 This Water Well Record was completed on (mo/day/year) under the business name of Geocore Inc by (signature) Dale Kell

INSTRUCTIONS: Use typewriter or ball point pen. Please press firmly and print clearly. Please fill in blanks, underline or circle the correct answers. Send top three copies to Kansas Department of Health and Environment, Bureau of Water, Geology Section, 1000 SW Jackson St., Ste. 420, Topeka, Kansas 66612-1367. Telephone: 785/296-5522. Send one to Water Well Owner and retain one for your records.