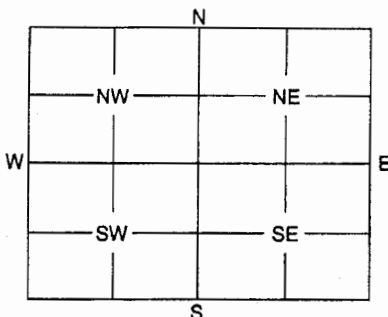


1	LOCATION OF WATER WELL:	Fraction	Section Number	Township Number	Range Number
	County: Rawlins	NE ¼ NW ¼ SE ¼	3	2	31 E/W

Distance and direction from nearest town or city street address of well if located within city?
105 Sunfield, Herndon

2	WATER WELL OWNER: Decatur Coop Association PO Box 68 RR #, St. Address, Box #: Overland Park, KS 67747 City, State, ZIP Code :	Board of Agriculture, Division of Water Resources Application Number:
---	---	--

3	MARK WELL'S LOCATION WITH AN "X" IN SECTION BOX: 	4 DEPTH OF WELL23..... ft. WELL'S STATIC WATER LEVEL19.5..... ft. WELL WAS USED AS: <table style="width:100%;"> <tr> <td>1 Domestic</td> <td>5 Public Water Supply</td> <td>9 Dewatering</td> </tr> <tr> <td>2 Irrigation</td> <td>6 Oil Field Water Supply</td> <td><input checked="" type="radio"/> 10 Monitoring Well</td> </tr> <tr> <td>3 Feedlot</td> <td>7 Domestic (Lawn & Garden)</td> <td>11 Injection Well</td> </tr> <tr> <td>4 Industrial</td> <td>8 Air Conditioning</td> <td>12 Other</td> </tr> </table> <p>Was a chemical / bacteriological sample submitted to Department? Yes No <input checked="" type="checkbox"/>..... If yes, mo/day/yr sample was submitted</p> <p>Water Well Disinfected: Yes No <input checked="" type="checkbox"/>.....</p>	1 Domestic	5 Public Water Supply	9 Dewatering	2 Irrigation	6 Oil Field Water Supply	<input checked="" type="radio"/> 10 Monitoring Well	3 Feedlot	7 Domestic (Lawn & Garden)	11 Injection Well	4 Industrial	8 Air Conditioning	12 Other
1 Domestic	5 Public Water Supply	9 Dewatering												
2 Irrigation	6 Oil Field Water Supply	<input checked="" type="radio"/> 10 Monitoring Well												
3 Feedlot	7 Domestic (Lawn & Garden)	11 Injection Well												
4 Industrial	8 Air Conditioning	12 Other												

5	TYPE OF BLANK CASING USED:	<table style="width:100%;"> <tr> <td>1 Steel</td> <td>3 RMP (SR)</td> <td>5 Wrought</td> <td>7 Fiberglass</td> <td>9 Other (Specify below)</td> </tr> <tr> <td><input checked="" type="radio"/> PVC</td> <td>4 ABS</td> <td>6 Asbestos-Cement</td> <td>8 Concrete Tile</td> <td>.....</td> </tr> </table> <p>Blank casing diameter2..... in. Was casing pulled? Yes <input checked="" type="checkbox"/> No If yes, how much23' *..... Casing height above or below land surface0..... in.</p>	1 Steel	3 RMP (SR)	5 Wrought	7 Fiberglass	9 Other (Specify below)	<input checked="" type="radio"/> PVC	4 ABS	6 Asbestos-Cement	8 Concrete Tile
1 Steel	3 RMP (SR)	5 Wrought	7 Fiberglass	9 Other (Specify below)								
<input checked="" type="radio"/> PVC	4 ABS	6 Asbestos-Cement	8 Concrete Tile								

6	GROUT PLUG MATERIAL:	<table style="width:100%;"> <tr> <td>1 Neat cement</td> <td>2 Cement grout</td> <td><input checked="" type="radio"/> Bentonite</td> <td><input checked="" type="radio"/> Other ..Native soil.....</td> </tr> </table> <p>Grout Plug Intervals: From0..... ft. to1..... ft., From1..... ft. to23..... ft., From to ft.</p> <p>What is the nearest source of possible contamination:</p> <table style="width:100%;"> <tr> <td>1 Septic tank</td> <td>6 Seepage pit</td> <td>11 Fuel storage</td> <td>16 Other (specify below)</td> </tr> <tr> <td>2 Sewer lines</td> <td>7 Pit privy</td> <td>12 Fertilizer storage</td> <td>.....</td> </tr> <tr> <td>3 Watertight sewer lines</td> <td>8 Sewage lagoon</td> <td>13 Insecticide storage</td> <td></td> </tr> <tr> <td>4 Lateral lines</td> <td>9 Feedyard</td> <td>14 Abandoned water well</td> <td></td> </tr> <tr> <td>5 Cess pool</td> <td>10 Livestock pens</td> <td>15 Oil well/Gas well</td> <td></td> </tr> </table> <p>Direction from well? How many feet?</p>	1 Neat cement	2 Cement grout	<input checked="" type="radio"/> Bentonite	<input checked="" type="radio"/> Other ..Native soil.....	1 Septic tank	6 Seepage pit	11 Fuel storage	16 Other (specify below)	2 Sewer lines	7 Pit privy	12 Fertilizer storage	3 Watertight sewer lines	8 Sewage lagoon	13 Insecticide storage		4 Lateral lines	9 Feedyard	14 Abandoned water well		5 Cess pool	10 Livestock pens	15 Oil well/Gas well	
1 Neat cement	2 Cement grout	<input checked="" type="radio"/> Bentonite	<input checked="" type="radio"/> Other ..Native soil.....																							
1 Septic tank	6 Seepage pit	11 Fuel storage	16 Other (specify below)																							
2 Sewer lines	7 Pit privy	12 Fertilizer storage																							
3 Watertight sewer lines	8 Sewage lagoon	13 Insecticide storage																								
4 Lateral lines	9 Feedyard	14 Abandoned water well																								
5 Cess pool	10 Livestock pens	15 Oil well/Gas well																								

FROM	TO	PLUGGING MATERIALS
0	1	Native soil
1	20	Bentonite (8")
20	23	Bentonite (2")

*Drilled out to 20'
MW3
GeoCore #1103

7	CONTRACTOR'S OF LANDOWNER'S CERTIFICATION: This water well was plugged under my jurisdiction and was completed on (mo/day/year)7/25/2006..... and this record is true to the best of my knowledge and belief. Kansas Water Well Contractor's License No.527..... This Water Well Record was completed on (mo/day/year)8/4/2006..... under the business name of GeoCore Inc. by (signature) <i>Dale Hol</i>
---	---

INSTRUCTIONS: Use typewriter or ball point pen. Please press firmly and print clearly. Please fill in blanks, underline or circle the correct answers. Send top three copies to Kansas Department of Health and Environment, Bureau of Water, Geology Section, 1000 SW Jackson St., Ste. 420, Topeka, Kansas 66612-1367. Telephone: 785/296-5522. Send one to Water Well Owner and retain one for your records.