

WATER WELL RECORD Form WWC-5

Division of Water Resources App. No.


20190231

Well ID

Original Record Correction Change in Well Use

1 LOCATION OF WATER WELL: County: Rawlins Fraction NE 1/4 NE 1/4 SW 1/4 NE 1/4 Section Number 16 Township Number T 2 S Range Number R 31 E W

2 WELL OWNER: Last Name: Business: Black Oak Exploration Address: 1474 S ST. Paul St. City: Denver State: CO ZIP: 80210 Street or Rural Address where well is located: Intersection of Rd 34 & Rd V

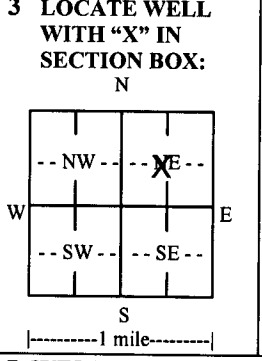

4 DEPTH OF COMPLETED WELL: 165 ft. Depth(s) Groundwater Encountered: 1) 110 ft. 2) ... 3) ... 4) Dry Well WELL'S STATIC WATER LEVEL: 110 ft. below land surface, measured on (mo-day-yr) 07/29/2019

5 Latitude: 39.8829 (decimal degrees) Longitude: 100.8017666 (decimal degrees) Datum: WGS 84 NAD 83 NAD 27 Source for Latitude/Longitude: GPS (unit make/model) (WAAS enabled? Yes No) Land Survey Topographic Map Online Mapper

6 Elevation: 2853 ft. Ground Level TOC Source: Land Survey GPS Topographic Map Other KOLAR

7 WELL WATER TO BE USED AS: 1. Domestic: Household Lawn & Garden Livestock Irrigation Feedlot Industrial 5. Public Water Supply: well ID 6. Dewatering: how many wells? 7. Aquifer Recharge: well ID 8. Monitoring: well ID 9. Environmental Remediation: well ID Air Sparge Soil Vapor Extraction Recovery Injection 10. Oil Field Water Supply: lease MW & MS Farms #. 11. Test Hole: well ID Cased Uncased Geotechnical 12. Geothermal: how many bores? a) Closed Loop Horizontal Vertical b) Open Loop Surface Discharge Inj. of Water 13. Other (specify):

Was a chemical/bacteriological sample submitted to KDHE? Yes No If yes, date sample was submitted: Water well disinfected? Yes No

8 TYPE OF CASING USED: Steel PVC Other CASING JOINTS: Glued Clamped Welded Threaded Casing diameter 4.5 in. to 165 ft., Diameter 18 in. to ... ft., Diameter ... in. to ... ft., Diameter ... in. to ... ft. Casing height above land surface 18 in. Weight 2.38 lbs./ft. Wall thickness or gauge No. 237

TYPE OF SCREEN OR PERFORATION MATERIAL: Steel Stainless Steel PVC Other (Specify) Brass Galvanized Steel None used (open hole)

SCREEN OR PERFORATION OPENINGS ARE: Continuous Slot Mill Slot Gauze Wrapped Torch Cut Drilled Holes Other (Specify) Louvered Shutter Key Punched Wire Wrapped Saw Cut None (Open Hole)

SCREEN-PERFORATED INTERVALS: From 125 ft. to 165 ft., From ... ft. to ... ft., From ... ft. to ... ft. GRAVEL PACK INTERVALS: From 20 ft. to 165 ft., From ... ft. to ... ft., From ... ft. to ... ft.

9 GROUT MATERIAL: Neat cement Cement grout Bentonite Other Grout Intervals: From 0 ft. to 20 ft., From ... ft. to ... ft., From ... ft. to ... ft.

Nearest source of possible contamination: No potential source of contamination within 200 ft. Septic Tank Lateral Lines Pit Privy Livestock Pens Insecticide Storage Sewer Lines Cess Pool Sewage Lagoon Fuel Storage Abandoned Water Well Watertight Sewer Lines Seepage Pit Feedyard Fertilizer Storage Oil Well/Gas Well Other (Specify)

Direction from well? Distance from well? ft.

Table with columns: 10 FROM, TO, LITHOLOGIC LOG, FROM, TO, LITHO. LOG (cont.) or PLUGGING INTERVALS. Rows: 0-2 surface, 2-13 loess, 13-25 clay, 25-128 caliche & clay w/ sand lenses, 128-155 fine to some med sand w/ clay lenses, 155-165 yellow ochre/black shale.

11 CONTRACTOR'S OR LANDOWNER'S CERTIFICATION: This water well was constructed, reconstructed, or plugged under my jurisdiction and was completed on (mo-day-year) 07/29/2019 and this record is true to the best of my knowledge and belief. Kansas Water Well Contractor's License No. 881 This Water Well Record was completed on (mo-day-year) 8/14/2019 under the business name of Wooter Pump and Well, Inc.



ASSIGNMENT OF WATER WELL TO LANDOWNER

I, Marlene Wolfram of 1312 West 2nd
(Landowner's address)

McCook Nebr. am the landowner on which a water well is located in the
(City) (State)

_____ quarter of the SE quarter of the NW quarter of the NE quarter of Section 16,
Township 2 S, Range 31 E/W in Rawlins County, Kansas which is approximately
4200 feet north/south, and 1460 feet east/west of the apparent SE section corner.

The water well was drilled in 7/29/2019 (month/year).

I hereby request that Black Oak Exploration, LLC leave the water well,
(Well operator/owner name)

which was drilled under Temporary/Term Water Permit # 20190231, unplugged, and I will
assume all responsibility for the plugging of said water well in accordance with the requirements of the
Kansas Department of Health and Environment regulation K.A.R. 28-30-7.

LANDOWNER:

Marlene Wolfram 9-23-19
(Signature) (Date)

marlene wolfram
(Print)

WELL OWNER:

[Signature] 9/11/19
(Signature) (Date)

By: Clayton Camozzi - Managing Partner
(Agent)

IF ADDITIONAL LANDOWNER

Marlyp Sitzman 9-23-19
(Signature) (Date)

Marlyp Sitzman
(Print)

BUREAU OF WATER
SEP 30 2019
RECEIVED