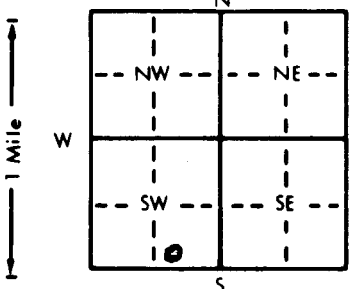


1 LOCATION OF WATER WELL: County: Rawlins Fraction W 1/2 Section Number 4 Township Number T 9 S Range Number R 36 E (N)

Distance and direction from nearest town or city street address of well if located within city? 7 north 1 east 1 north 1/2 west of McDonald

2 WATER WELL OWNER: Victor Cahoj RR#, St. Address, Box #: P.O. Box 203 City, State, ZIP Code: Agro, KS 67621 Board of Agriculture, Division of Water Resources Application Number:

3 LOCATE WELL'S LOCATION WITH AN "X" IN SECTION BOX:  4 DEPTH OF COMPLETED WELL: 257 ft. ELEVATION: 0 ft. Depth(s) Groundwater Encountered: 160-257 ft. 2. 0 ft. 3. 0 ft. WELL'S STATIC WATER LEVEL: 160 ft. below land surface measured on mo/day/yr: 9-24-92 Pump test data: Well water was 210 ft. after 1 hours pumping 3 gpm Est. Yield: 3 gpm: Well water was 210 ft. after 1 hours pumping 3 gpm Bore Hole Diameter: 12 in. to 257 ft., and 12 in. to 257 ft. WELL WATER TO BE USED AS: 5 Public water supply 8 Air conditioning 11 Injection well 1 Domestic 3 Feedlot 6 Oil field water supply 9 Dewatering 12 Other (Specify below) 2 Irrigation 4 Industrial 7 Lawn and garden only 10 Monitoring well Was a chemical/bacteriological sample submitted to Department? Yes X No X If yes, mo/day/yr sample was submitted Water Well Disinfected? Yes X No X

5 TYPE OF BLANK CASING USED: 1 Steel 3 RMP (SR) 5 Wrought iron 8 Concrete tile CASING JOINTS: Glued X Clamped Welded Threaded 2 PVC 4 ABS 6 Asbestos-Cement 9 Other (specify below) Blank casing diameter: 5 in. to 217 ft., Dia. 5 in. to 217 ft., Dia. Casing height above land surface: 12 in., weight 200 lbs./ft. Wall thickness or gauge No. TYPE OF SCREEN OR PERFORATION MATERIAL: 1 Steel 3 Stainless steel 5 Fiberglass 8 RMP (SR) 10 Asbestos-cement 2 Brass 4 Galvanized steel 6 Concrete tile 9 ABS 11 Other (specify) 12 None used (open hole) SCREEN OR PERFORATION OPENINGS ARE: 1 Continuous slot 3 Mill slot 5 Gauzed wrapped 8 Saw cut .016 11 None (open hole) 2 Louvered shutter 4 Key punched 6 Wire wrapped 9 Drilled holes 7 Torch cut 10 Other (specify) SCREEN-PERFORATED INTERVALS: From 217 ft. to 257 ft., From 217 ft. to 257 ft., From 217 ft. to 257 ft. GRAVEL PACK INTERVALS: From 257 ft. to 20 ft., From 257 ft. to 20 ft., From 257 ft. to 20 ft.

6 GROUT MATERIAL: 1 Neat cement 2 Cement grout 3 Bentonite 4 Other Grout Intervals: From 0 ft. to 20 ft., From 0 ft. to 20 ft., From 0 ft. to 20 ft. What is the nearest source of possible contamination: None 10 Livestock pens 14 Abandoned water well 1 Septic tank 4 Lateral lines 7 Pit privy 11 Fuel storage 15 Oil well/Gas well 2 Sewer lines 5 Cess pool 8 Sewage lagoon 12 Fertilizer storage 16 Other (specify below) 3 Watertight sewer lines 6 Seepage pit 9 Feedyard 13 Insecticide storage Direction from well? How many feet?

FROM	TO	LITHOLOGIC LOG	FROM	TO	PLUGGING INTERVALS
<u>0</u>	<u>158</u>	<u>clay</u>			
<u>158</u>	<u>192</u>	<u>SS, clay</u>			
<u>192</u>	<u>210</u>	<u>sand</u>			
<u>210</u>	<u>235</u>	<u>clay + sand</u>			
<u>235</u>	<u>255</u>	<u>sand + gr.</u>			
<u>255</u>	<u>257</u>	<u>clay</u>			

7 CONTRACTOR'S OR LANDOWNER'S CERTIFICATION: This water well was (1) constructed, (2) reconstructed, or (3) plugged under my jurisdiction and was completed on (mo/day/year) 9-24-92 and this record is true to the best of my knowledge and belief. Kansas Water Well Contractor's License No. 286 This Water Well Record was completed on (mo/day/yr) 10-2-92 under the business name of Wilcox Drilling by (signature) Bob Wilcox

INSTRUCTIONS: Use typewriter or ball point pen. PLEASE PRESS FIRMLY and PRINT clearly. Please fill in blanks, underline or circle the correct answers. Send top three copies to Kansas Department of Health and Environment, Bureau of Water, Topeka, Kansas 66620-7320. Telephone: 913-296-5545. Send one to WATER WELL OWNER and retain one for your records.