

WATER WELL RECORD Form WWC-5

Original Record Correction Change in Well Use


Division of Water Resources App. No.

20180086

Well ID

1 LOCATION OF WATER WELL:
 County: **Cheyenne** Fraction SE ¼ SE ¼ SE ¼ NW ¼ Section Number **22** Township Number **T 2 S** Range Number **R 37** E W

2 WELL OWNER: Last Name: _____ First: _____
 Business: **Murfin Drilling Co. Inc.** Street or Rural Address where well is located (if unknown, distance and direction from nearest town or intersection): If at owner's address, check here:
 Address: **250 N Water Ste 300** Intersection of Road U and Road 32 2310' north and 2970' west
 Address: _____
 City: **Wichita** State: **KS** ZIP: **67202**

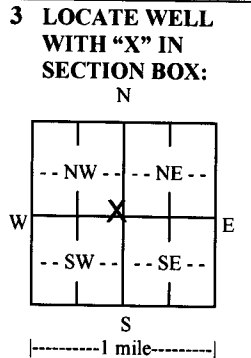

4 DEPTH OF COMPLETED WELL: ... **300** ... ft.
 Depth(s) Groundwater Encountered: 1) ... **200** ... ft.
 2) ft. 3) ft., or 4) Dry Well
WELL'S STATIC WATER LEVEL: ... **200** ... ft.
 below land surface, measured on (mo-day-yr) **03/30/2018**
 above land surface, measured on (mo-day-yr)
 Pump test data: Well water was ft.
 after hours pumping gpm
 Well water was ft.
 after hours pumping gpm
 Estimated Yield: ... **50** ... gpm
 Bore Hole Diameter: ... **8** ... in. to **300** ... ft. and
 in. to ft.

5 Latitude: ... **39.866435** (decimal degrees)
Longitude: ... **101.45805** (decimal degrees)
 Datum: WGS 84 NAD 83 NAD 27
Source for Latitude/Longitude:
 GPS (unit make/model:)
 (WAAS enabled? Yes No)
 Land Survey Topographic Map
 Online Mapper:
6 Elevation: **3410** ft. Ground Level TOC
Source: Land Survey GPS Topographic Map
 Other **KOLAR**

7 WELL WATER TO BE USED AS:

1. Domestic: Household Lawn & Garden Livestock
 Irrigation
 Feedlot
 Industrial

2. Public Water Supply: well ID

3. Dewatering: how many wells?

4. Aquifer Recharge: well ID

5. Monitoring: well ID

6. Environmental Remediation: well ID

7. Air Sparge Soil Vapor Extraction
 Recovery Injection

8. Oil Field Water Supply: lease .. **Banister 'A' 1-22**

9. Test Hole: well ID

10. Cased Uncased Geotechnical

11. Geothermal: how many bores?

12. a) Closed Loop Horizontal Vertical
 b) Open Loop Surface Discharge Inj. of Water

13. Other (specify):

Was a chemical/bacteriological sample submitted to KDHE? Yes No If yes, date sample was submitted:

Water well disinfected? Yes No

8 TYPE OF CASING USED: Steel PVC Other CASING JOINTS: Glued Clamped Welded Threaded
 Casing diameter ... **4.5** ... in. to ... **260** ... ft., Diameter in. to ft., Diameter in. to ft.
 Casing height above land surface ... **18** ... in. Weight ... **2.38** ... lbs./ft. Wall thickness or gauge No. **237**

TYPE OF SCREEN OR PERFORATION MATERIAL:
 Steel Stainless Steel Fiberglass PVC Other (Specify)
 Brass Galvanized Steel Concrete tile None used (open hole)

SCREEN OR PERFORATION OPENINGS ARE:
 Continuous Slot Mill Slot Gauze Wrapped Torch Cut Drilled Holes Other (Specify)
 Louvered Shutter Key Punched Wire Wrapped Saw Cut None (Open Hole)

SCREEN-PERFORATED INTERVALS: From ... **260** ... ft. to ... **300** ... ft., From ft. to ft., From ft. to ft.
GRAVEL PACK INTERVALS: From ... **20** ... ft. to ... **300** ... ft., From ft. to ft., From ft. to ft.

9 GROUT MATERIAL: Neat cement Cement grout Bentonite Other

Grout Intervals: From ... **0** ... ft. to ... **20** ... ft., From ft. to ft., From ft. to ft.

Nearest source of possible contamination:
 Septic Tank Lateral Lines Pit Privy Livestock Pens Insecticide Storage
 Sewer Lines Cess Pool Sewage Lagoon Fuel Storage Abandoned Water Well
 Watertight Sewer Lines Seepage Pit Feedyard Fertilizer Storage Oil Well/Gas Well
 Other (Specify)

Direction from well? Distance from well? ft.

10 FROM	TO	LITHOLOGIC LOG	FROM	TO	LITHO. LOG (cont.) or PLUGGING INTERVALS
0	2	Surface	270	282	Clay with Sand Lens
2	20	Loess	282	297	Fine & Medium Sand
20	44	Clay	297	310	Black Shale
44	62	Clay with Caliche Lens			
62	203	Clay & Caliche with Sand Lens			
203	212	Fine Sand with Cemented Strks			
212	218	Fine to Some Medium Sand with Cement	Notes:		
218	257	Clay & Caliche with Sand Strks			
257	270	Fine to Some Medium Sand			

11 CONTRACTOR'S OR LANDOWNER'S CERTIFICATION: This water well was constructed, reconstructed, or plugged under my jurisdiction and was completed on (mo-day-year) **03/29/2018** and this record is true to the best of my knowledge and belief. Kansas Water Well Contractor's License No. **881** This Water Well Record was completed on (mo-day-year) **04/09/2018** under the business name of **Woofter Pump and Well, Inc.**



ASSIGNMENT OF WATER WELL TO LANDOWNER

K.E. J Banister Farms, L.P.
I, Kent Banister, PTR. of 301 Henderson Ave
(Landowner's address)

McDonald KS am the landowner on which a water well is located in the
(City) (State)

SE quarter of the SE quarter of the SE quarter of the NW quarter of Section 22,
Township 2 S, Range 37 E/W in Cheyenne County, Kansas which is approximately
2310 feet north south, and 2970 feet east/west of the apparent SW section corner.

The water well was drilled in 04/18 (month/year).

I hereby request that Murkin Drlg Co. leave the water well,
(Well operator/owner name)

which was drilled under Temporary/Term Water Permit # 20180086, unplugged, and I will
assume all responsibility for the plugging of said water well in accordance with the requirements of the
Kansas Department of Health and Environment regulation K.A.R. 28-30-7.

LANDOWNER:

Kent Banister 5-16-19
(Signature) (Date)

KENT L. BANISTER
(Print)

WELL OWNER:

[Signature] 5-23-19
(Signature) (Date)

By: Klint Farr
(Agent)

IF ADDITIONAL LANDOWNER

[Signature] 5-16-19
(Signature) (Date)

JOAN BANISTER
(Print)

WATER RESOURCES
RECEIVED

RECEIVED

JUN 03 2019

OCT 16 2019

KS DEPT OF AGRICULTURE